

JAN 28 1999

Montmorency County Remonumentation

SECTION

LAND CORNER RECORDATION CERTIFICATE

Filing Requirement of Act 74, Mich. P.A. 1970.iber 00012 Page 0331

For corners in

MONTMORENCY (County)

Located In:

Corner Code =#

ALBERT TWP.

1. Public Land Survey

T 29N R 1 E

C - 12

T R

T R

T R

T R

2. Property Controlling in Section

S T R

S T R

3. Miscellaneous

S T R

Property in Sec.

S T R

STATE OF MICHIGAN MONTMORENCY COUNTY Recorded & Filed

12-07-1998 09:37:46

MARY JO GUEST

REGISTER OF DEEDS Register of Deeds Stamp & File Number

4. Lot No. Recorded Plat

5. Private Claims

Grid table with columns A-M and rows 2-13. Contains numbers 1-36 in a grid pattern.

DONALD E MARLATT in a field survey on MAY 19 98

do hereby certify that under requirements of P.A. 74, Michigan P.A. of 1970, the corner points mentioned in lines 1 and 2 above were in conformance with regulations and rules therefore as required in the current manual of survey instructions of the United States Department of the Interior, Bureau of Land Management or by a decree of a Court of Law and/or that the corner points mentioned in lines 3, 4 and 5 above were in conformance with the rules of the Michigan Board of Land Surveyors or by a Decree of a Court of Law; established, re-established, monumented, re-monumented, recovered, found as expressed below:

NOTE: Not more than 4 corners, all in the same town and range, may be recorded on this certificate.

A. Description of original monument and accessories and/or subsequent restoration:

- C - 12 1/4 COR. COMMON TO SEC.'S 31 & 32. GLO CORNER SET BY LEWIS CLASON APRIL 1840. Y.PINE 12" S65°W 61 L.-ASPEN 4" N83°E 28 L. MAP FROM FRANK SMITH RLS#754 FILES, NO DATE. PLAT OF ADDITION TO LYLE PARK BY FRANK SMITH 3/1/47. L. 1, P. 73. SURVEY BY LEO SMITH RLS #10706 9/5/59. SURVEY BY N.C.CALDWELL RLS#12018 11/15/71. FOUND 1"PIPE. SURVEY BY G.D. HENNING RLS# 2240 5/17/76. SURVEY BY L. BEAUREGARD RLS#18654 8/16/77. L. 2, P. 339. FOUND 1"PIPE. SURVEY BY L. BEAUREGARD 9/15/88. L. 3, P. 453. FOUND 1"PIPE. SURVEY BY FRED KING RLS#25852 7/23/84 L. 3, P. 255. SURVEY BY FRED KING 7/23/84. L. #. P. 256.

APPROVED BY PEER GROUP

JUL 28 98

L.E.B.

3. Description of corner evidence found and/or method applied in restoring or reestablishing cor.


C - 12 1/4 COR. COMMON TO SEC.'S 31 & 32. FOUND 1"PIPE. S37°35'E 6"OAK 36' S37°W 9"OAK 41.5'

THERE IS NO APPARENT CONFLICTING EVIDENCE.

2. Description of monument for corner and accessories established to perpetuate locating the position of the corner:

C - 12 1/4 CORNER COMMON TO SEC.'S 31 & 32. SET CONC. MONUMENT AND REMON. CAP. S20°W 15" W. OAK 45.15' S34°E 16"R. OAK 35.90' N70°W 10"R. OAK 23.55' N13°E 9"R.OAK 26.41'

WITNESSES MARKED WITH 40 PENNY SPIKES AND P.S. TAGS#18660 APPROVED BY PEER GROUP JULY 28, 1998 AS THE BEST AVAILABLE EVIDENCE OF THE POSITION OF THE ORIGINAL CORNER.

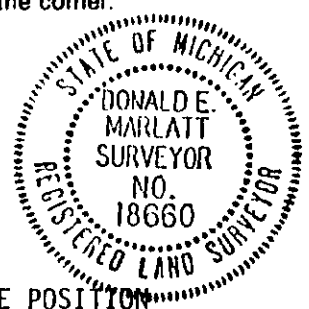

Signed by Donald E Marlatt

Date 12/4/1998

Surveyor's Michigan License No. 18660