

JAN 28 1999

Montmorency County Remonumentation

SECTION

Liber 00012 Page 0333

LAND CORNER RECORDATION CERTIFICATE

Filing Requirement of Act 74, Mich. P.A. 1970

For corners in MONTMORENCY

Located In: Corner Code -#

STATE OF MICHIGAN MONTMORENCY COUNTY Recorded & Filed

12-07-1998 09:39:05

MARY JO GUEST REGISTER OF DEEDS

Register of Deeds Stamp & File Number

(County)	ALBERT TWP.		
1. Public Land Survey	T 29 N. R 1 E	D - 5	
	T R		
	T R		
	T R		
2. Property Controlling in Section	S T R		
	S T R		
3. Miscellaneous Property in Sec.	S T R		
	S T R		

- 4. Lot No. \_\_\_\_\_, Recorded Plat \_\_\_\_\_
- 5. Private Claims \_\_\_\_\_


A	B	C	D	E	F	G	H	I	J	K	L	M
2	6	5	4	3	2							
3												
4	7	8	9	10	11	12						
5												
6	16	17	18	15	14	13						
7												
8	19	20	21	22	23	24						
9												
10	30	29	28	27	26	25						
11												
12	31	32	33	34	35	36						
13												

I, DONALD E MARLATT, in a field survey on MAY, 19 98, do hereby certify that under requirements of P.A. 74, Michigan P.A. of 1970, the corner points mentioned in lines 1 and 2 above were in conformance with regulations and rules therefore as required in the current manual of survey instructions of the United States Department of the Interior, Bureau of Land Management or by a decree of a Court of Law and/or that the corner points mentioned in lines 3, 4 and 5 above were in conformance with the rules of the Michigan Board of Land Surveyors or by a Decree of a Court of Law; established, re-established, monumented, re-monumented, recovered, found as expressed below:

**NOTE: Not more than 4 corners, all in the same town and range, may be recorded on this certificate.**

A. Description of original monument and accessories and/or subsequent restoration:  
 D - 5 1/4 COR. COMMON TO SEC.'S 8 & 17.  
 GLO COR. SET BY LEWIS CLASON APRIL 1840.  
 W. PINE 8" N43°E 11 L.  
 W. PINE 9" S74°W 10 L.

B. Description of corner evidence found and/or method applied in restoring or reestablishing corner:  
 D - 5 1/4 COR. COMMON TO SEC.'S 8 & 17.  
 NO EVIDENCE OF CORNER FOUND.  
 SET CORNER BY SINGLE PROPORTION.

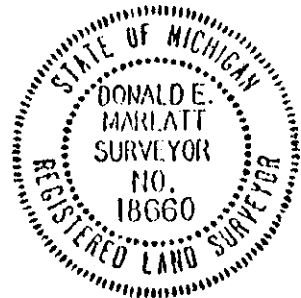

C. Description of monument for corner and accessories established to perpetuate locating the position of the corner:  
 D - 5 1/4 COR. COMMON TO SEC.'S 8 & 17.  
 SET CONC. MONUMENT AND REMON CAP.  
 N42°W 9"W PINE 17.32'  
 N35°E 8"MAPLE 13.67'  
 N77°E 8"MAPLE 31.2'  
 N69°W 10"MAPLE 21.52'

**APPROVED BY PEER GROUP**

JUL 28 98

*LJB*

WITNESSES MARKED WITH 40 PENNY SPIKES AND P.S. TAGS#18660.  
 APPROVED BY PEER GROUP ON JULY 28, 1998 AS A CAREFUL AND FAITHFUL ESTABLISHMENT OF THE POSITION OF THE CORNER,

Signed by Donald E Marlatt Date 12/4/1998  
 Surveyor's Michigan License No. 18660