

JAN 28 1999

SECTION

LAND CORNER RECORDATION CERTIFICATE
Filing Requirement of Act 74, Mich. P.A. 1970

For corners in

MONTMORENCY
(County)

Located In:

Corner Code #

ALBERT TWP.

1. Public Land Survey

T 29N R 1E

D - 7

T R

T R

T R

S T R

2. Property Controlling in Section

S T R

S T R

3. Miscellaneous

S T R

Property in Sec.

S T R

4. Lot No. _____, Recorded Plat _____

5. Private Claims _____

STATE OF MICHIGAN
MONTMORENCY COUNTY
Recorded & Filed

12-07-1998 09:38:13

MARY JO GUEST
REGISTER OF DEEDS

Register of Deeds Stamp & File Number

I, DONALD E MARLATT, in a field survey on MAY, 19 98,

do hereby certify that under requirements of P.A. 74, Michigan P.A. of 1970, the corner points mentioned in lines 1 and 2 above were in conformance with regulations and rules therefore as required in the current manual of survey instructions of the United States Department of the Interior, Bureau of Land Management or by a decree of a Court of Law and/or that the corner points mentioned in lines 3, 4 and 5 above were in conformance with the rules of the Michigan Board of Land Surveyors or by a Decree of a Court of Law; established, re-established, monumented, re-monumented, recovered, found as expressed below:

NOTE: Not more than 4 corners, all in the same town and range, may be recorded on this certificate.


	A	B	C	D	E	F	G	H	I	J	K	L	M
2	6	5	4	3	2	1							
3													
4	7	8	9	10	11	12							
5													
6	18	17	16	15	14	13							
7													
8	19	20	21	22	23	24							
9													
10	30	29	28	27	26	25							
11													
12	31	32	33	34	35	36							
13													

A. Description of original monument and accessories and/or subsequent restoration:

D - 7 1/4 COR. COMMON TO SEC.'S 17 & 20.
GLO COR. SET BY LEWIS CLASON APRIL 1840. SPR. PINE 12" S43°E 33 L.-SPR.PINE 12" N63°W 44 L. SURVEY L. BEAUREGARD RLS#18654 10/1970. FOUND 3/8"BAR(R) NO WIT. MARKED.(BELIEVED TO HAVE BEEN SURVEY BY L. BEAUREGARD 11/7/77. SET S.P. BY G.HENNING 1965-1970).
SURVEY BY D.E. MARLATT RLS #18660 10/1/96. FOUND 1/2"ROD. L. 10004, P. 423. WIT. N45°E 40.45' 12"OAK-N60°W 22.5' 9"RED PINE- 1/2"ROD & CAP#18654 EAST & WEST.
SURVEY BY D.E.MARLATT 11-1-96. L. 10004, P. 430. FOUND 1/2"ROD.(WIT. SAME AS ABOVE).
SURVEY BY L. BEAUREGARD 11/25/96. FOUND 1/2"BAR(R). EAST 33' BAR & RLS CAP-WEST 33' BAR & RLS CAP-N45°E 40.34' 12"W.OAK EX. NAIL-N60°W 22.38' 6"N.PINE EX. NAIL.

B. Description of corner evidence found and/or method applied in restoring or reestablishing corner:

D - 7 1/4 COR. COMMON TO SEC.'S 17 & 20.
FOUND 1/2" ROD
N45°E 40.45' 12"OAK-N60°W 22.5' 9"R.PINE. 1/2"RODS & CAPS 33' EAST & WEST.

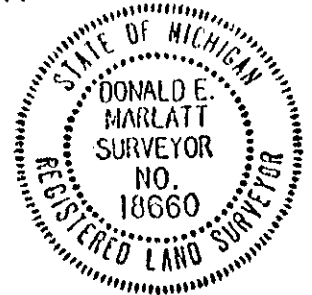

C. Description of monument for corner and accessories established to perpetuate locating the position of the corner:

D - 7 1/4 COR. COMMON TO SEC.'S 17 & 20.
SET CONC. MONUMENT AND REMON. CAP.
N45°E 40.45' 12"OAK
N60°W 22.5' 9"R.PINE
WEST 33' 1/2"ROD & CAP#18654
EAST 33' 1/2"ROD & CAP#18654

APPROVED BY
PEER GROUP

JUL 28 98

L.G.B.

WITNESSES MARKED WITH 40 PENNY SPIKE & P.S. TAG#18660.
APPROVED BY PEER GROUP ON JULY 28, 1998 AS THE BEST AVAILABLE EVIDENCE OF THE POSITION OF THE ORIGINAL CORNER.

Signed by *Donald E Marlatt*

Date *12/4/1998*

Surveyor's Michigan License No. 18660