SURVEY & REMONUMENTATION

APR 2 4 1995

COMMISSION

Liber 00012 Page 0123

Montmorency County Remonumentation

LAND CORNER RECORDATION CERTIFICATE

Filing Requirement of Act 74, Mich. P.A. 1970

For corners in

Montmorency (County)

	Located In: Albert Township	Corner Code ##
1. Public Land Survey	T 29 N R 1 E	D-13 ✓
	T 29 N R 1 E	E-13
	T ___ R ___	
	T ___ R ___	
2. Property Controlling	S ___ T ___ R ___	
in Section	S ___ T ___ R ___	
3. Miscellaneous	S ___ T ___ R ___	
Property in Sec.	S ___ T ___ R ___	

APPROVED BY PEER GROUP

MAY 1 3 94

STATE OF MICHIGAN
MONTMORENCY COUNTY
Recorded & Filed

11-10-1994 14:11:25

A. PANGAN-MCELROY
REGISTER OF DEEDS

Register of Deeds Stamp & File Number

4. Lot No. _____ , Recorded Plat _____
5. Private Claims _____

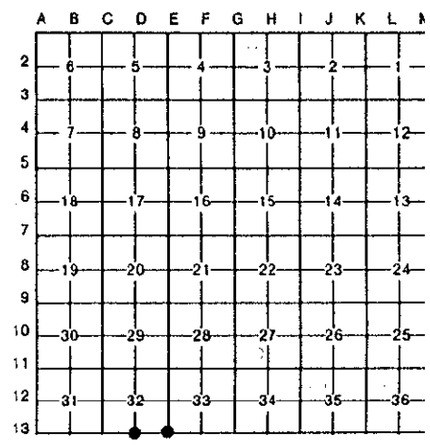

I, Don Marlatt, in a field survey on November 8, 19 94, do hereby certify that under requirements of P.A. 74, Michigan P.A. of 1970, the corner points mentioned in lines 1 and 2 above were in conformance with regulations and rules therefore as required in the current manual of survey instructions of the United States Department of the Interior, Bureau of Land Management or by a decree of a Court of Law and/or that the corner points mentioned in lines 3, 4 and 5 above were in conformance with the rules of the Michigan Board of Land Surveyors or by a Decree of a Court of Law; established, re-established, monumented, re-monumented, recovered, found as expressed below:

NOTE: Not more than 4 corners, all in the same town and range, may be recorded on this certificate.

A. Description of original monument and accessories and/or subsequent restoration:

(D-13) S. ¼ Cor. Sec. 32, T 29 N, R 1 E
Post set by Lewis Clawson Dec. 1839.
8" Spr. Pine S 42° W 14 links
9" Spr. Pine S 5° E 10 links

(E-13) South Cor. common to Secs. 32 & 33, T 29 N, R 1
Post set by Lewis Clawson Dec. 1839.
9" Spr. Pine N 27° W 9 links
9" Spr. Pine N 53° E 25 links

R.S. Scott Engineering - Survey - L. 2, P. 146.

D. Marlatt - Survey - L. 3, P. 350.

B. Description of corner evidence found and/or method applied in restoring or reestablishing corner:

(D-13) S. ¼ Cor. Sec. 32, T 29 N, R 1 E
Found Square Cedar Post.
12" J. Pine N 50° E 36'
13" W. Pine S 15° W 11.29'
N. ¼ Cor. Sec. 5, 28/1, 37.07' East

No evidence of original corner.

Accepted as the best available evidence of the reestablishment of the original corner.

(E-13) South Cor. common to Secs. 32 & 33, T 29 N, R 1
Found ½" rod in concrete.
N. ¼ Cor. Sec. 6, 28/1, 37.7' East.

No evidence of original corner.

Accepted as the best available evidence of the reestablishment of the original corner.

C. Description of monument for corner and accessories established to perpetuate locating the position of the corner:

(D-13) S. ¼ Cor. Sec. 32, T 29 N, R 1 E
Set concrete monument & placed Remonumentation Cap.
12" J. Pine N 10° W 26.2'
12" J. Pine N 50° E 36.0'
14" J. Pine N 70° E 19.51'
16" W. Pine S 28° E 38.95'
13" W. Pine S 15° W 11.29'

Witnesses marked with a 30 penny spike & I.D. tag #18660.

(E-13) South Cor. common to Secs. 32 & 33, T 29 N, R 1
Left ½" rod in concrete & placed Remon. Cap.
28" Oak S 50° W 56.28'
29" Oak N 40° W 66.94'
10" Oak N 55° E 62.74'
13" Oak N 84° E 57.30'

STATE OF MICHIGAN
DONALD E. MARLATT
SURVEYOR
NO. 18660
REGISTERED LAND SURVEYOR

Signed by Donald E Marlatt Date 11-9-1994

Surveyor's Michigan License No. 18660

FORM APPROVED BY MICHIGAN STATE BOARD OF LAND SURVEYORS, JAN. 28, 197
REVISED MAY 14, 197
REVISED JAN., 198