

JAN 28 1999

SECTION

LAND CORNER RECORDATION CERTIFICATE
Filing Requirement of Act 74, Mich. P.A. 1970

For corners in

<u>MONTMORENCY</u> (County)	Located in:	Corner Code #
ALBERT TWP.	T29N R1E	E - 4
1. Public Land Survey	T R	
	T R	
	T R	
2. Property Controlling in Section	S T R	
	S T R	
3. Miscellaneous Property in Sec.	S T R	
	S T R	

STATE OF MICHIGAN
MONTMORENCY COUNTY
Recorded & Filed

12-07-1998 09:38:43

MARY JO GUEST
REGISTER OF DEEDS

Register of Deeds Stamp & File Number

4. Lot No. _____, Recorded Plat _____
5. Private Claims _____

I, DONALD E MARLATT, in a field survey on MAY, 19 98 do hereby state that under requirements of P.A. 74, Michigan P.A. of 1970, the corner points mentioned in lines 1 and 2 above were in conformance with regulations and rules therefore as required in the current manual of survey instructions of the United States Department of the Interior, Bureau of Land Management or by a decree of a Court of Law and for that the corner points mentioned in lines 3, 4 and 5 above were in conformance with the rules of the Michigan Board of Land Surveyors or by a Decree of a Court of Law; established, re-established, monumented, recovered, found as expressed below:

NOTE: Not more than 2 corners, all in the same town and range, may be recorded on this certificate.

	A	B	C	D	E	F	G	H	I	J	K	L	M
1													
2	6		5		4		3		2		1		
3													
4	7		8		9		10		11		12		
5													
6	18		17		16		15		14		13		
7													
8	19		20		21		22		23		24		
9													
10	30		29		28		27		26		25		
11													
12	31		32		33		34		35		36		
13													

A. Description of original monument and accessories and/or subsequent restoration:

E - 4 1/4 COR. COMMON TO SEC.'S 8 & 9
GLO COR. SET LEWIS CLASON APRIL 1840. SPR. PINE 10" N31°E 30 L.-Y.pine 10" S29°W 20 L.
FRANK SMITH RLS #754 NOTES. B. OAK 8" S55°45'W 37.4' - B. OAK 8" N53°20'E 54.6'
UNABLE TO FIND OCT. 24, 1945. SET CEDAR STAKE-NBT OAK 6" S75°W 13.8'.

B. Description of corner evidence found and/or method applied in restoring or reestablishing corner:

E-4 1/4 COR. COMMON TO SEC.'S 8 & 9.
FOUND 1/2" ROD & CAP #18654.
S66°W 12" OAK 37.15' - N 5°E 12" RED PINE 12.88'.


APPROVED BY
PEER GROUP

JUL 28 98

L.S.B.

C. Description of monument for corner and accessories established to perpetuate locating the position of the corner:

E - 4 1/4 COR. COMMON TO SEC.'S 8 & 9.
SET CONC. MONUMENT & REMON. CAP.
N 5°E 12" RED PINE 12.88'
N60°E 8" RED PINE 11.38'
S30°W 9" OAK 14.41'
S66°W 11" OAK 20.85'
S66°W 12" OAK 37.15' (DEAD)

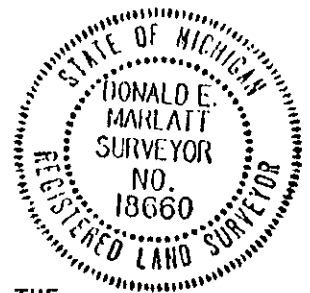

WITNESSES MARKED WITH 40 PENNY SPIKES & P.S. TAGS #18660
APPROVED BY PEER GROUP ON JULY 28, 1998 AS THE BEST AVAILABLE EVIDENCE OF THE ORIGINAL CORNER.

Signed by Donald E Marlatt
Surveyor's Michigan License No. 18660

Date 12/4/1998