

JAN 28 1998

SECTION

Montmorency County Remonumentation

Liber 00012 Page 0338

LAND CORNER RECORDATION CERTIFICATE
Filing Requirement of Act 74, Mich. P.A. 1970

For corners in

Table with columns: MONTMORENCY (County), Located in:, Corner Code #. Includes entries for ALBERT TWP. Public Land Survey and Property Controlling in Section.

STATE OF MICHIGAN
MONTMORENCY COUNTY
Recorded & Filed

12-07-1998 09:38:50

MARY JO GUEST
REGISTER OF DEEDS

Register of Deeds Stamp & File Number

4. Lot No. , Recorded Plat
5. Private Claims

I, DONALD E MARLATT, in a field survey on MAY 19 98 do hereby state that under requirements of P.A. 74, Michigan P.A. of 1970, the corner points mentioned in lines 1 and 2 above were in conformance with regulations and rules therefore as required in the current manual of survey instructions of the United States Department of the Interior, Bureau of Land Management or by a decree of a Court of Law and/or that the corner points mentioned in lines 3, 4 and 5 above were in conformance with the rules of the Michigan Board of Land Surveyors or by a Decree of a Court of Law; established, re-established, monumented, recovered, found as expressed below:

NOTE: Not more than 2 corners, all in the same town and range, may be recorded on this certificate.

Grid table with columns A-M and rows 1-13. Contains numerical data points for survey locations.

A. Description of original monument and accessories and/or subsequent restoration:

E-5 SEC. CORNER COMMON TO SEC.'S 8-9-16 & 17.
GLO COR. SET BY LEWIS CLASON APRIL 1840. SPR. PINE 6" N24°W 14 L.-SPR.PINE 6" S53°E 23 L.
FRANK SMITH RLS#754 NOTES-MADE NBT OAK 7" S29°E 8.2'
SURVEY BY L. BEAUREGARD RLS#18654 1/16/1975.SET 1/2"BAR & CAP FROM F.SMITH (R)NBT.(ABOVE)
WIT. S32°E 8.2' 7"OAK(R)-N70°E 34.65' 8"OAK-S30°W 31.2' 12"J.PINE-WEST 25.2' 12"J.PINE.
ACT 74 BY L. BEAUREGARD 1/16/76. L. 1, P.154. (SAME AS ABOVE)
SURVEY BY DAN SCHRIPSEMA RLS#24617 7/26/89. L. 3, P. 558. FD. 1/2"IRON WITH CAP.
WIT. S32°E 3.2' 7"OAK-N70°E 34.65' 8"OAK-S30°W 31.3' T.POLE.
SURVEY BY D.E.MARLATT RLS#18660 10/1/96. L. 10004, P. 424. FOUND 1/2"ROD. N10°W 12"J.PINE 41.07'-N34°E 15"OAK 51.05'- N50°E 12"OAK 36.35'-N76°E 12"OAK 34.85'.
SURVEY D.E.MARLATT 11/1/96. L. 10004, P. 430. (SAME AS ABOVE)
SURVEY BY STEVEN BYE RLS#35991 11/18/97. fd. 1/2"IRON ROD. 10"J.PINE N12°W 41.04' 13"OAK N49°E 36.35'-12"OAK N83°E 34.81'- 6"J.PINE S10°E 37.10'.

B. Description of corner evidence found and/or method applied in restoring or reestablishing cor.

E - 5 SEC. CORNER COMMON TO SEC.'S 8-9-16 & 17.
FOUND 1/2"ROD & CAP#18654
N10°W 14"J.PINE 41.1'-N49°E 13"OAK 36.46'-N77°E 12"OAK 34.81'-S10°E 8"J.PINE 37.03'.


C. Description of monument for corner and accessories established to perpetuate locating the position of the corner:

E - 5 CORNER COMMON TO SEC.'S 8-9-16 & 17.
SET CONC. MONUMENT AND REMON. CAP.
N10°W 14"J.PINE 41.1' R.
N49°E 13"OAK 36.46' R.
N77°E 12"OAK 34.81'(NBT)
S10°E 8"J.PINE 37.03' R.

APPROVED BY
PEER GROUP

JUL 28 98

J.S.B.

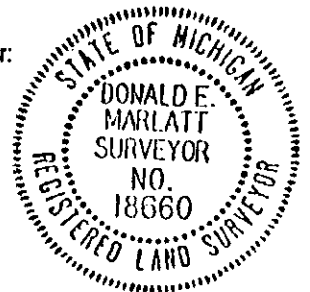

WITNESSES MARKED WITH 40 PENNY SPIKES AND P.S. TAG#18660.
APPROVED BY PEER GROUP ON JULY 28, 1998 AS THE BEST AVAILABLE EVIDENCE OF THE POSITION OF THE ORIGINAL CORNER.

Signed by Donald E Marlatt
Surveyor's Michigan License No. 18660

Date 12/4/1998