

FEB 06 1998

Montmorency County Remonumentation

Liber 00012 Page 0290

SECTION

LAND CORNER RECORDATION CERTIFICATE

Filing Requirement of Act 74, Mich. P.A. 1970

For corners in

MONTMORENCY

(County)

ALBERT TWP.

Located In:

Corner Code ##

T 29N R 1E

G - 5

STATE OF MICHIGAN
MONTMORENCY COUNTY
Recorded & Filed

12-16-1997 10:52:35

A. FANGAN-MCELROY
REGISTER OF DEEDS

Register of Deeds Stamp & File Number

1. Public Land Survey

T R

T R

T R

T R

2. Property Controlling in Section

S T R

S T R

3. Miscellaneous

S T R

Property in Sec.

S T R

4. Lot No. _____, Recorded Plat _____

5. Private Claims _____

I, DONALD E. MARLATT, in a field survey on 6/11 19 97

do hereby certify that under requirements of P.A. 74, Michigan P.A. of 1970, the corner points mentioned in lines 1 and 2 above were in conformance with regulations and rules therefore as required in the current manual of survey instructions of the United States Department of the Interior, Bureau of Land Management or by a decree of a Court of Law and/or that the corner points mentioned in lines 3, 4 and 5 above were in conformance with the rules of the Michigan Board of Land Surveyors or by a Decree of a Court of Law; established, re-established, monumented, re-monumented, recovered, found as expressed below:

NOTE: Not more than 4 corners, all in the same town and range, may be recorded on this certificate.

	A	B	C	D	E	F	G	H	I	J	K	L	M
2	6	5	4	3	2	1							
3													
4	7	8	9	10	11	12							
5													
6	18	17	16	15	14	13							
7													
8	19	20	21	22	23	24							
9													
10	30	29	28	27	26	25							
11													
12	31	32	33	34	35	36							
13													

A. Description of original monument and accessories and/or subsequent restoration:

G - 5 CORNER COMMON TO SEC.'S 9-10-15 & 16.
GLO COR. SET BY LEWIS CLASON APRIL 1840. SPR.PINE 7"-S46°W-24 L., SPR.PINE 7"-N55°E- 25 L.
SURVEY BY N.C.CALDWELL JUNE 1969. FD. 1/2"BAR & AT EAST EDGE OF ROAD.
N75°E 44.0' 12"J.PINE(NBT), S60°E 18.0' T.POLE, N80°W 47.9' 8"J.PINE.
ACT 74 BY NC CALDWELL 8-7-1972. L.1, P. 27. PLACE RLS CAP ON 1/2"BAR(SAME WIT. AS ABOVE).
SURVEY BY N.C. CALDWELL 12-31-1973. L. 1, P. 503-505. FD. 1/2"BAR & RLS CAP(WIT. SAME AS ABOVE).
ACT 74 BY N.C.CALDWELL 2-26-1974 L.1, P. 91. fd 1/2"BAR & RLS CAP.(WIT. SAME AS ABOVE).
SURVEY BY R.S.SCOTT ENG. CO. INC. 1-16-76. FD. 1/2"BAR & CAP. EAST SIDE OF ROAD.
N75°E 44.0' 12"J.PINE (NBT), N80°W 47.90' 8"J.PINE (NBT).
ACT 74 BY L. BEAUREGARD 1-16-76. L.1, P.154. FD. 1/2"BAR & RLS CAP.(WIT. SAME AS ABOVE).
SURVEY BY R.S.SCOTT ASSO. INC. 5-21-77. L. 2, P. 286.
SURVEY BY R.S.SCOTT ASSO. INC. 5-7-82. L. 3, P. 145. FD. 1/2"BAR & RLS CAP(ACT 74 WITNESSES)
ACT 74 BY D. PORTER 12-8-87. L.1,P. 424. FD. 1/2"ROD & LLS CAP#12018.
N30°E 75.42' 6"OAK, N34°W 77.22' 8"J.PINE, N19°W 93.12' 8"J.PINE.
SURVEY BY R.S.SCOTT ASSO. INC. 6-3-88. L. 3, P. 442.(SAME AS L. BEAUREGARD ACT 74, L.1,P.154).
SURVEY BY WILCOX & ASSO. INC. 7-26-89. L. 3,P.558. FD 1/2"IRON W/CAP(USED L. BEAUREGARD
ACT 74 WITNESSES L.1, P. 154).

B. DESCRIPTION OF CORNER EVIDENCE FOUND AND/OR METHOD APPLIED IN RESTORING OR REESTABLISHING CORNER.

G-5 CORNER COMMON TO SEC.'S 9-10-15 & 16.
FD 1/2"ROD & CAP #12018 ON EAST SIDE OF ROAD. (D.PORTER WITNESSES)
N32°E 13"OAK 75.9', N34°W 8"J.PINE 77.22'
N15°W 10"J.PINE 93.13'


C. Description of monument for corner and accessories established to perpetuate locating the position of the corner:

G - 5 SEC. CORNER COMMON TO SEC.'S 9-10-15 & 16.
SET CONC. MONUMENT WITH REMON. CAP.
N34°W 8"J.PINE 77.22'
N32°E 13"OAK 75.9'
N15°W 10"J.PINE 93.13'
S39°W 12"J.PINE 87.2'

APPROVED BY
PEER GROUP

JUN 20 97

L.S.B.

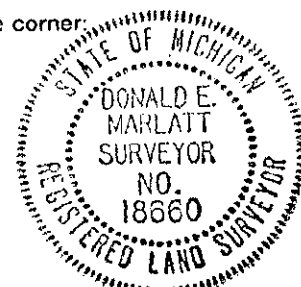

WITNESSES MARKED WITH 40 PENNY SPIKES AND P.S. TAGS# 18660.
APPROVED BY PEER GROUP JUNE 20, 1997 AS THE BEST AVAILABLE EVIDENCE OF THE POSITION OF THE ORIGINAL CORNER.

Signed by Donald E Marlatt

Date 12/15/1997

Surveyor's Michigan License No. 18660