

FEB 06 1998

SECTION

LAND CORNER RECORDATION CERTIFICATE
Filing Requirement of Act 74, Mich. P.A. 1970

For corners in

MONTMORENCY (County) ALBERT TWP.

Located In:

Corner Code #

- 1. Public Land Survey T 29N R 1E G - 6
2. Property Controlling in Section S T R
3. Miscellaneous Property in Sec. S T R

STATE OF MICHIGAN MONTMORENCY COUNTY Recorded & Filed

12-16-1997 10:52:27

A. PANGAN-MCELROY REGISTER OF DEEDS

Register of Deeds Stamp & File Number

- 4. Lot No. , Recorded Plat
5. Private Claims

Grid table with columns A-M and rows 2-13. Cell 6F contains a black dot.

1. DONALD E MARLATT, in a field survey on 6/16, 19 97 do hereby certify that under requirements of P.A. 74, Michigan P.A. of 1970, the corner points mentioned in lines 1 and 2 above were in conformance with regulations and rules therefore as required in the current manual of survey instructions of the United States Department of the Interior, Bureau of Land Management or by a decree of a Court of Law and/or that the corner points mentioned in lines 3, 4 and 5 above were in conformance with the rules of the Michigan Board of Land Surveyors or by a Decree of a Court of Law; established, re-established, monumented, re-monumented, recovered, found as expressed below:

NOTE: Not more than 4 corners, all in the same town and range, may be recorded on this certificate.

A. Description of original monument and accessories and/or subsequent restoration:

G - 6 1/4 COR. COMMON TO SEC.'S 15 & 16. GLO POST SET BY LEWIS CLASON APRIL 1840. SPR. PINE 8"-N31°W-35 L., SPR. PINE 8"-S16°E-18 L. FRANK SMITH NOTES. FD. OLD VALENTINE WIT. STP. & REESTABLISHED POST 10-17-45. SET IRON PIPE 28'WEST & 4'NORTH OF OLD FENCE COR.MADE NBT. JACK 4"-S60°15'W 33.7', JACK 6"-N41°45'W 42'. N.C.CALDWELL SURVEY JUNE 1969. FD. 1"PIPE & RAISED WITH 1/2" & RLS CAP. N32°W 42' F. SMITH STP.-S60°W 33.7' FRANK SMITH STP., S40°W 58.65' 8"J.PINE, S60°E 54.3' 10"OAK, N50°E 54.0' 10"J.PINE, S75°W 21.5' 1/2"BAR. ACT 74 BY N.C.CALDWELL 8-7-72. L.1, P.27. CORNER & WIT. THE SAME AS ABOVE EXCEPT 2 F.S. STPS.) SURVEY BY R.S.SCOTT ENG. CO. INC. 1-16-76. fd. 1/2" & CAP NEAR W. EDGE OF ROAD. S40°W 58.65' 8"J.PINE, S60°E 54.3' 10"OAK, N50°E 54' 10"J.PINE. ACT 74 BY L. BEAUREGARD 1-16-76. L.1, P. 154.(SAME AS ABOVE) SURVEY BY R.S.SCOTT ASSO. INC. 5-7-82. L. 3, P. 145.(SAME COR. & WIT. AS ABOVE). SURVEY BY R.S.SCOTT ASSO. INC. 5-26-87. L. 3, P. 388. (SAME COR. & WIT. AS ABOVE). SURVEY BY D.E.MARLATT 6-7-89. FD. EXISTING 1/2"ROD & CAP.(SAME COR. & WIT. AS ABOVE). SURVEY BY D.E.MARLATT 6-22-93 . FD. 1/2"ROD & CAP. S40°W 58.65' 8"J.PINE, S60°E 54.3' 10"OAK, N50°E 54' 10"J.PINE, S72°W 44.44' 14"J.PINE, S78°E 14"J.PINE 43.9'. SURVEY BY F. KING 6-21-94. L. 4, P. 188.

B. Description of corner evidence found and/or method applied in restoring or reestablishing cor.

G-6 1/4 COR. COMMON TO SEC.'S 15 & 16. FD. 1/2"ROD & CAP. S69°W 16"J.PINE 43.9', S78°E 16"J.PINE 44.4', S50°E 13"OAK 54.1' (ALSO FOUND 1"PIPE BELOW).


C. Description of monument for corner and accessories established to perpetuate locating the position of the corner:

G - 6 1/4 COR. COMMON TO SEC.'S 15 & 16. SET CONC. MONUMENT & REMON. CAP S69°W 16"J.PINE 43.90' N43°W 15"J.PINE 59.29' N51°E 16"J.PINE 66.16' S78°E 16"J.PINE 44.40' S50°E 13"OAK 54.10'(DEAD)

APPROVED BY PEER GROUP

JUN 20 97

Signature

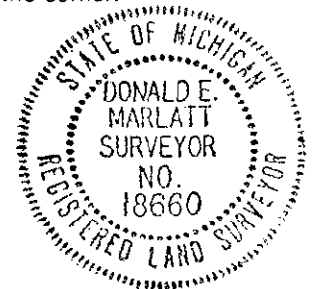

WITNESSES MARKED WITH 40 PENNY SPIKES & P.S. TAGS # 18660. APPROVED BY PEER GROUP JUNE 20, 1997 AS THE BEST AVAILABLE EVIDENCE OF THE POSITION OF THE ORIGINAL CORNER.

Signed by Donald E Marlatt

Date 12/15/1997

Surveyor's Michigan License No. 18660