

**SURVEY & REMONUMENTATION**

APR 24 1995

**Montmorency County Remonumentation**

**LAND CORNER RECORDATION CERTIFICATE**

Filing Requirement of Act 74, Mich. P.A. 1970

**COMMISSION**

For corners in

STATE OF MICHIGAN  
MONTMORENCY COUNTY  
Recorded & Filed

11-10-1994 14:11:37

A. PANGAN-MCELROY  
REGISTER OF DEEDS

Register of Deeds Stamp & File Number

Montmorency (County) Located In: Albert Township Corner Code #F

1. Public Land Survey T 29 NR 1 E F-13  
T 29 NR 1 E G-13 ✓

2. Property Controlling S T R  
in Section S T R

3. Miscellaneous S T R  
Property in Sec. S T R

APPROVED BY PEER GROUP  
MAY 13 94

4. Lot No. \_\_\_\_\_, Recorded Plat \_\_\_\_\_  
5. Private Claims \_\_\_\_\_

I, Don Marlatt, in a field survey on November 8, 19 94, do hereby certify that under requirements of P.A. 74, Michigan P.A. of 1970, the corner points mentioned in lines 1 and 2 above were in conformance with regulations and rules therefore as required in the current manual of survey instructions of the United States Department of the Interior, Bureau of Land Management or by a decree of a Court of Law and/or that the corner points mentioned in lines 3, 4 and 5 above were in conformance with the rules of the Michigan Board of Land Surveyors or by a Decree of a Court of Law; established, re-established, monumented, re-monumented, recovered, found as expressed below:

**NOTE: Not more than 4 corners, all in the same town and range, may be recorded on this certificate.**

	A	B	C	D	E	F	G	H	I	J	K	L	M
2	6		5		4		3		2		1		
3													
4	7		8		9		10		11		12		
5													
6	18		17		16		15		14		13		
7													
8	19		20		21		22		23		24		
9													
10	30		29		28		27		26		25		
11													
12	31		32		33		34		35		36		
13													

**A. Description of original monument and accessories and/or subsequent restoration:**

(F-13) S. 1/4 Cor. Sec. 33, T 29 N, R 1 E  
Post set by Lewis Clawson Dec. 1839.  
24" J. Pine N 34° W 81 links  
18" J. Pine N 31° E 41 links

County Rd. Commission Notes:  
12" Y. Pine N 34° W 7.1'  
12" Y. Pine N 45° E 9.8'

(G-13) South Cor. common to Secs. 33 & 34, T 29 N, R 1 E  
Post set by Lewis Clawson Dec. 1839.  
4" J. Pine N 63° W 85 links  
26" J. Pine N 63° E 50 links

County Rd. Commission Notes:  
6" Oak N 25° W 15.25'  
6" Oak S 44° W 32.05'

D. Marlatt - Survey - 2-14-85.

**B. Description of corner evidence found and/or method applied in restoring or reestablishing corner:**

(F-13) S. 1/4 Cor. Sec. 33, T 29 N, R 1 E  
Found concrete monument.  
9" Oak N 75° W 24.93'  
8" Oak N 28° E 29.1'  
N. 1/4 Cor. Sec. 4, 28/1, 24.5' East.

No evidence of original corner.

Accepted as the best available evidence of the reestablishment of the original corner.

(G-13) South Cor. common to Secs. 33 & 34, T 29 N, R 1 E  
Found concrete monument.  
10" Oak N 20° W 17.6'  
9" Oak S 50° E 20.5'  
10" Oak N 40° E 18.88'

North Cor. common to Secs. 3 & 4, 28/1, 14.4' East.

No evidence of original corner.


Accepted as the best available evidence of the reestablishment of the original corner.

**C. Description of monument for corner and accessories established to perpetuate locating the position of the corner:**

(F-13) S. 1/4 Cor. Sec. 33, T 29 N, R 1 E  
Placed Remonumentation Cap on concrete monument.  
10" Oak S 7° W 15.65'  
12" Stump S 10° W 15.42'  
9" Oak N 75° W 24.93'  
10" Oak S 81° W 37.44'

Witnesses marked with a 30 penny spike & I.D. tag #18660.

(G-13) South Cor. common to Secs. 33 & 34, T 29 N, R 1 E  
Placed Remonumentation Cap on concrete monument.  
11" Oak N 17° W 17.63'  
16" Oak S 50° W 15.02'  
11" Oak S 21° W 28.55'  
9" Oak S 54° E 20.75'

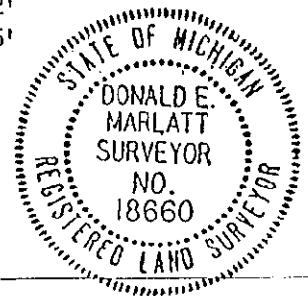

Signed by Donald E Marlatt

Date 11-9-1994

Surveyor's Michigan License No. 18660