

FEB 06 1998

SECTION

LAND CORNER RECORDATION CERTIFICATE
Filing Requirement of Act 74, Mich. P.A. 1970

For corners in

Table with columns: MONTMORENCY (County), Located In: (Town/Range/Section), Corner Code #. Includes entries for ALBERT TWP. Public Land Survey and Property Controlling in Section.


STATE OF MICHIGAN
MONTMORENCY COUNTY
Recorded & Filed

12-16-1997 10:53:46

A. PANGAN-MCELROY
REGISTER OF DEEDS

Register of Deeds Stamp & File Number

4. Lot No. , Recorded Plat
5. Private Claims

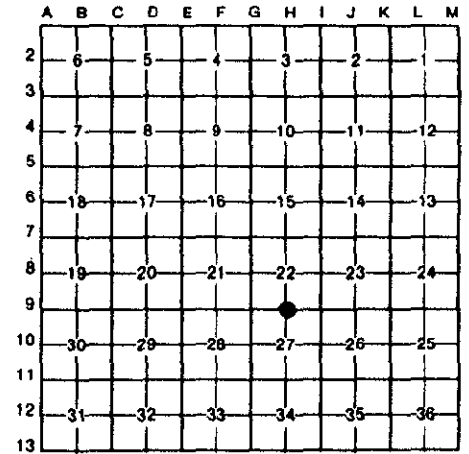

I, DONALD E MARLATT, in a field survey on 7/9, 19 97, do hereby certify that under requirements of P.A. 74, Michigan P.A. of 1970, the corner points mentioned in lines 1 and 2 above were in conformance with regulations and rules therefore as required in the current manual of survey instructions of the United States Department of the Interior, Bureau of Land Management or by a decree of a Court of Law and/or that the corner points mentioned in lines 3, 4 and 5 above were in conformance with the rules of the Michigan Board of Land Surveyors or by a Decree of a Court of Law; established, re-established, monumented, re-monumented, recovered, found as expressed below:

NOTE: Not more than 4 corners, all in the same town and range, may be recorded on this certificate.

A. Description of original monument and accessories and/or subsequent restoration:

H-9 1/4 COR. COMMON TO SEC.'S 22 & 27.
GLO POST SET BY LEWIS CLASON IN APRIL 1840. W.PINE 8"-N57°E-19'L, Y.PINE 10"-S47°W-50 L.
FRANK SMITH NOTES-SEPT 13, 1943-NO COR. DESCRIPTION. BALM 30"-N9°W 42.3', BALM N41°W 85.7' FENCE S. 51.3', IRON POST N. 52.8'. (FD. R.R.SPIKE)
BIRCH GROVE SUB. L. 2 OF PLATS, PAGE 5, STANLEY THORSEN 1958. LEO SMITH SURVEY 4-18-1959.
BIRCH GROVE SUB. #2 L. 2 OF PLATS, P. 69- N.C.CALDWELL 3-7-69.
BIRCH GROVE SUB #3 L. 2 OF PLATS, P. 99-100, N.C. CALDWELL 4-20-1972.
MONTMORENCY CO. ROAD PLANS. FD. 1/2"ROD. N12°15'W 41.8' 30"POPLAR, N33°20"W 70' SE COR. OF GAS ISLE, S 4°15'W 51.25' FENCE COR. DATED 6-26-78, SURVEY BY N.C.CALDWELL.
FRED KING SURVEY L. 4, P. 84, 12-8-92, FD. IRON IN MONUMENT BOX, NO WITNESS.

B. Description of corner evidence found and/or method applied in restoring or reestablishing corner:

H-9 1/4 COR. COMMON TO SEC'S 22 & 27
FOUND 1/2"ROD & CAP#18660 IN MONUMENT BOX. NO WITNESSES FOUND.

APPROVED BY
PEER GROUP

JUL 11 97


D.S.B.

NO EVIDENCE OF ORIGINAL COR.

C. Description of monument for corner and accessories established to perpetuate locating the position of the corner:

H-9 1/4 COR. COMMON TO SEC.'S 22 & 27.
PLACED REMON. CAP ON 1/2"ROD IN MONUMENT BOX.
S 1°E P.POLE 42.35'
N65°E S.W. COR. OF BLDG. 107.1'
N 4°W S.E. COR OF BLDG. 88.30'
S54°E N.W. COR. BLDG. 132.75'

WITNESSES MARKED WITH 40 PENNY SPIKES & P.S. TAGS #18660.
APPROVED BY PEER GROUP ON JULY 11, 1997 AS THE BEST AVAILABLE EVIDENCE OF THE POSITION OF THE ORIGINAL CORNER.

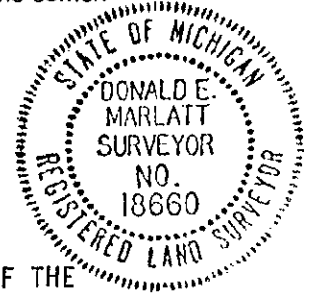

Signed by Donald E Marlatt

Date 12/15/1997

Surveyor's Michigan License No. #18660