

Montmorency County Remonumentation

APR 24 1995

LAND CORNER RECORDATION CERTIFICATE
Filing Requirement of Act 74, Mich. P.A. 1970

STATE OF MICHIGAN
MONTMORENCY COUNTY
Recorded & Filed

COMMISSION
For corners in

11-10-1994 14:12:02

A. PANGAN-MCELROY
REGISTER OF DEEDS

Montmorency (County) Located In: Albert Township Corner Code # I-13

1. Public Land Survey T 29 N R 1 E I-13
T R
T R
T R

2. Property Controlling in Section S T R
S T R

3. Miscellaneous Property in Sec. S T R
S T R

4. Lot No. , Recorded Plat

5. Private Claims

APPROVED BY
PEER GROUP

MAY 13 94

DM

Register of Deeds Stamp & File Number

A	B	C	D	E	F	G	H	I	J	K	L
2	6	5	4	3	2						
3											
4	7	8	9	10	11	12					
5											
6	18	17	16	15	14	13					
7											
8	19	20	21	22	23	24					
9											
10	30	29	28	27	26	25					
11											
12	31	32	33	34	35	36					
13											

I, Don Marlatt, in a field survey on November 8, 19 94, do hereby certify that under requirements of P.A. 74, Michigan P.A. of 1970, the corner points mentioned in lines 1 and 2 above were in conformance with regulations and rules therefore as required in the current manual of survey instructions of the United States Department of the Interior, Bureau of Land Management or by a decree of a Court of Law and/or that the corner points mentioned in lines 3, 4 and 5 above were in conformance with the rules of the Michigan Board of Land Surveyors or by a Decree of a Court of Law; established, re-established, monumented, re-monumented, recovered, found as expressed below:

NOTE: Not more than 4 corners, all in the same town and range, may be recorded on this certificate.

A. Description of original monument and accessories and/or subsequent restoration:

- (I-13) Meander Cor. on North shore of Little Wolf Lake, Lewis Clawson Dec. 1839. No witnesses marked.
- W. Caldwell - Wolf Lake Estates - P.S.
- N. Caldwell - Pine Forest Estates - P.S.

B. Description of corner evidence found and/or method applied in restoring or reestablishing corner:


- (I-13) Found No Corner. Set corner at intersection of Section Line & the South Line. of Lot #17 of Pine Forest Estates.

The Peer Group accepted as monumenting a witness corner on Section Line common to Secs. 34 & 35 on North shore of Little Wolf Lake.

C. Description of monument for corner and accessories established to perpetuate locating the position of the corner:

- (I-13) Witness corner on North shore of Little Wolf Lake between Secs. 34 & 35, T 29 N, R 1 E. Set 1/2" rod & Remonumentation Cap in tree roots.
 - 10" J. Pine North 1.03'
 - 12" W. Pine N 71° E 49.17'
 - 14" J. Pine N 78° W 41.37'
 - Conc. Mon. S 72° W 11.79'

Witnesses marked with a 30 penny spike & I.D. tag #18660.

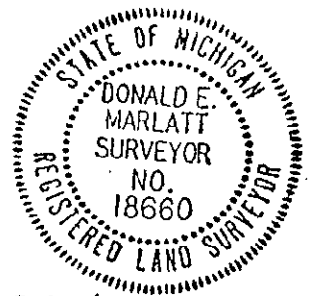

Signed by Donald E. Marlatt

Date 11-9-1994

Surveyor's Michigan License No. 18660