

LAND CORNER RECORDATION CERTIFICATE

FILING REQUIREMENT OF ACT 74, MICH. P.A.1970

FOR CORNERS OF --:	LOCATED IN --:	CORNER CODE NUMBER
1. PUBLIC LAND SURVEY	T. 29 N. R. 2 E.	F-1; F-3; I-1; J-1; K-1
2. PROPERTY CONTROLLING IN SECTION	T. N. S., R. W.	
3. MISCELLANEOUS PROPERTY IN SECTION	T. N. S., R. W.	
4. LOT NO., RECORDED PLAT		
5. PRIVATE CLAIMS		

REGISTER OF DEEDS STAMP AND FILING NUMBER

I, Kenneth J. Ostling, do hereby certify that under requirements of P.A. 74, Michigan P.A. of 1970, the corner points mentioned in lines 1 and 2 above were, in a field survey on June 30, 1977, established, re-established, monumented, re-monumented, recovered or restored as expressed below and in conformance with regulations and rules therefore as required in the current manual of survey instructions of the United States Department of the Interior, Bureau of Land Management or by a decree of a court of law. Furthermore, that the corner points mentioned in lines 3, 4 and 5 above were, in a field survey on _____, 19____, found, recovered, restored, established or re-established as expressed below and in conformance with the rules of the Michigan State Board of Registration for Land Surveyors or, by a Decree of a Court of law:

~~As described in the original plat or as shown on subsequent subdivisions~~

C. (continued)

J-1	K-1
Set DNR mon. & red-top post	DNR mon. in place-set cedar post
3" J. Pine S53°W 24.4	10" Oak S16°W 12.15
3" J. Pine S01°E 54.3	12" R. Pine stp. S78°E 30.1
18" R. Pine S86°E 109.35	SE corner Sec. 35 T30N R2E
S¼ Sec. 35 T30N R2E is 19.22 W	is 14.57 W

B. Description of corner evidence found and/or method applied in restoring or re-establishing corner:

- F-1 Set corner by proportionate measurement, M.P.O.L., between section corners.
- F-3 Found iron bar at corner as previously established by G.F. DeLaMater survey. U.S.B.T. stump in place with good face.
- I-1 Found corner as established by DeLaMater survey and used in subsequent surveys by Leo Smith, D. Marlatt, G. Henning & others. Found & used in 1960 survey by this department.
- J-1 Set corner by proportionate measurement, midpoint on line, between section corners.
- K-1 Corner previously found in 1960 DNR survey. Found a ½" iron bar (in 1960) which had been found and used by F. Smith in 1941 survey.

C. Description of monument for corner and accessories established to perpetuate locating the position of the corner:

F-1	F-3	I-1
Set DNR mon. & red-top post	Set DNR mon. at 5/8" bar	Left conc. mon. in place, set
4" Maple S43°E 34.8	& cedar post	cedar post
6" W. Oak S62°W 42.72	18" Oak S40°E 11.15	18" Oak S15°W 24.9
S¼ Sec. 33 T30N R2E W 16.20	5" Oak N17°E 22.8	3" R. Pine S68°E 22.3
	R. Pine stp. (OBT)	SE corner Sec. 34 T30N R2E
	S50°W 26.4	is 19.6' West
	R. Pine stp. NBT (GFD)	
	N35°W 4.4	


SIGNED BY Kenneth Ostling DATE 7/15/77

SURVEYOR'S MICHIGAN REGISTRATION NO. 10068

FOR STATE AND UNITED STATES AGENCIES:

SIGNED BY _____ DATE _____
CHIEF OF SURVEY PARTY

APPROVED AND SIGNED BY _____ DATE _____
MICHIGAN REGISTERED LAND SURVEYOR

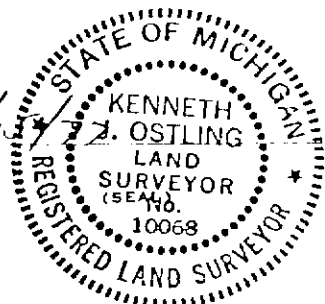

SURVEYOR'S MICHIGAN REGISTRATION NO. _____ MONTMORENCY COUNTY