

MAY 1 1997

COMMISSIONER

Montmorency County Remonumentation

Liber 00012 Page 0210

LAND CORNER RECORDATION CERTIFICATE

Filing Requirement of Act 74, Mich. P.A. 1970

For corners in MONTMORENCY

(County)

Located In:

Corner Code #

ALBERT TWP.

1. Public Land Survey

T 29N R 2E

B - 1

T R

T R

T R

2. Property Controlling in Section

S T R

S T R

3. Miscellaneous Property in Sec.

S T R

S T R

STATE OF MICHIGAN MONTMORENCY COUNTY Recorded & Filed

11-01-1996 09:42:48

A. PANGAN-MCELROY REGISTER OF DEEDS

Register of Deeds Stamp & File Number

4. Lot No. , Recorded Plat

5. Private Claims

DONALD E MARLATT in a field survey on MAY 30 19 96

do hereby certify that under requirements of P.A. 74, Michigan P.A. of 1970, the corner points mentioned in lines 1 and 2 above were in conformance with regulations and rules therefore as required in the current manual of survey instructions of the United States Department of the Interior, Bureau of Land Management or by a decree of a Court of Law and/or that the corner points mentioned in lines 3, 4 and 5 above were in conformance with the rules of the Michigan Board of Land Surveyors or by a Decree of a Court of Law; established, re-established, monumented, re-monumented, recovered, found as expressed below:

NOTE: Not more than 4 corners, all in the same town and range, may be recorded on this certificate.

A. Description of original monument and accessories and/or subsequent restoration:

B - 1 NORTH 1/4 COR. SEC. 6

NO CORNER SET ON ORIGINAL SURVEY

ACT 74 BY KEN OSTLING L. 1, P. 202, 3-1-1978

DNR SURVEY SEPT. 1977.

SET DNR MONUMENT BY S.P. METHOD.

20" OAK S37°E 93.65'

18" MAPLE S78°E 40.5'

B. Description of corner evidence found and/or method applied in restoring or reestablishing corner:

B - 1 NORTH 1/4 COR. SEC. 6

FOUND DNR MONUMENT

S75°E 22" MAPLE 41.08' (NBT)

N50°W 30" CHERRY 69.5' (NBT)

S35°E 24" OAK 93.74'

APPROVED BY PEER GROUP

JUN 07 96

S.A.B.

S. 1/4 COR. OF SEC, 31, T30N, R2E IS 6.6' WEST

C. Description of monument for corner and accessories established to perpetuate locating the position of the corner:

B - 1 NORTH 1/4 CORNER OF SEC. 6, T29N, R2E.


LEFT DNR MONUMENT IN PLACE. (1" PIPE WITH 4" CAP)

S75°E 22" MAPLE 41.08' (NBT)

N75°E 21" MAPLE 71.0'

N50°W 30" CHERRY 69.5' (NBT)

S35°E 24" W. OAK 93.74'

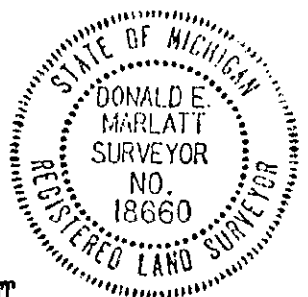

WITNESSES MARKED WITH 30PENNY SPIKES & P.S. TAGS #18660.

APPROVED BY PEER GROUP JUNE 7, 1996 AS A CAREFUL AND FAITHFUL ESTABLISHMENT OF THE POSITION OF THE CORNER.

Signed by Donald E Marlatt

Date 10-28-1996

Surveyor's Michigan License No. 18660