

MAY 16 1997

COMMISSION

Montmorency County Remonumentation

Liber 00012 Page 0211

LAND CORNER RECORDATION CERTIFICATE

Filing Requirement of Act 74, Mich. P.A. 1970

For corners in MONTMORENCY

Located In: Corner Code #

STATE OF MICHIGAN MONTMORENCY COUNTY Recorded & Filed

11-01-1996 09:42:58

A. PANGAN-MCELROY REGISTER OF DEEDS

Register of Deeds Stamp & File Number

Table with 3 columns: Survey Type, Located In (T/R), Corner Code #. Includes entries for Public Land Survey, Property Controlling in Section, and Miscellaneous Property in Sec.

4. Lot No. , Recorded Plat
5. Private Claims

Grid table with columns A-M and rows 2-13. A dot is marked in cell C2.

I, DONALD E MARLATT, in a field survey on MAY 30, 1996, do hereby certify that under requirements of P.A. 74, Michigan P.A. of 1970, the corner points mentioned in lines 1 and 2 above were in conformance with regulations and rules therefore as required in the current manual of survey instructions of the United States Department of the Interior, Bureau of Land Management or by a decree of a Court of Law and/or that the corner points mentioned in lines 3, 4 and 5 above were in conformance with the rules of the Michigan Board of Land Surveyors or by a Decree of a Court of Law; established, re-established, monumented, re-monumented, recovered, found as expressed below:

NOTE: Not more than 4 corners, all in the same town and range, may be recorded on this certificate.

A. Description of original monument and accessories and/or subsequent restoration: C - 1 NORTH CORNER COMMON TO SEC'S 5 & 6 CORNER SET BY LEWIS CLASON 3-20-1839 ASPEN 6"-S56°E-6, ASPEN 8"-S66°W-10 ACT 74 BY KEN OSTLING L. 1, P. 202, 3-1-1978. SET DNR MONUMENT U.S. RECORD E. OF STANDARD COR. 8"MAPLE N15°W 1.6' 8"BASSWOOD S32°W 40.2'

B. Description of corner evidence found and/or method applied in restoring or reestablishing corner: C - 1 NORTH CORNER COMMON TO SEC'S 5 & 6 FOUND DNR MONUMENT N30°W 12"MAPLE 1.47' N22°E 9"MAPLE 44.44'


APPROVED BY PEER GROUP

JUN 07 96

L.A.B.

CORNER COMMON TO SEC'S 31 & 32, T30N, R2E 6.66'WEST. NO EVIDENCE OF ORIGINAL CORNER.

C. Description of monument for corner and accessories established to perpetuate locating the position of the corner: C - 1 NORTH CORNER COMMON TO SEC'S 5 & 6, T29N, R2E. LEFT DNR MONUMENT IN PLACE (1"PIPE WITH 4"CAP) N 3°W 12"MAPLE 1.47' S73°E 9"POPLAR 17.2' N22°E 9"MAPLE 44.44' N80°E 11"MAPLE 65.0'

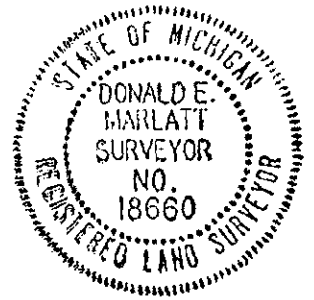

WITNESSES MARKED WITH 30 PENNY SPIKES & P.S. TAG # 18660 APPROVED BY PEER GROUP JUNE 7, 1996 AS THE BEST AVAILABLE EVIDENCE OF THE REESTABLISHMENT OF THE ORIGINAL CORNER.

Signed by Donald E Marlatt Date 10/28/96 Surveyor's Michigan License No. 18660