

MAY 1 8 1987

COMMISSION

Montmorency County Remonumentation

Liber 00012 Page 0212

LAND CORNER RECORDATION CERTIFICATE
Filing Requirement of Act 74, Mich. P.A. 1970

For corners in
MONTMORENCY

(County)

ALBERT TWP.

1. Public Land Survey

Located In:

Corner Code #

T 29N R 2E

D - 1

T R

T R

T R

2. Property Controlling
in Section

S T R

S T R

3. Miscellaneous
Property in Sec.

S T R

S T R

4. Lot No. _____, Recorded Plat _____

5. Private Claims _____

STATE OF MICHIGAN
MONTMORENCY COUNTY
Recorded & Filed

11-01-1996 09:43:07

A. PANGAN-MCELROY
REGISTER OF DEEDS

Register of Deeds Stamp & File Number

	A	B	C	D	E	F	G	H	I	J	K	L	M
2	6		5		4		3		2		1		
3													
4	7		8		9		10		11		12		
5													
6	18		17		16		15		14		13		
7													
8	19		20		21		22		23		24		
9													
10	30		29		28		27		26		25		
11													
12	31		32		33		34		35		36		
13													

DONALD E. MARLATT

MAY 30, 1996

I, DONALD E. MARLATT, in a field survey on MAY 30, 1996, do hereby certify that under requirements of P.A. 74, Michigan P.A. of 1970, the corner points mentioned in lines 1 and 2 above were in conformance with regulations and rules therefore as required in the current manual of survey instructions of the United States Department of the Interior, Bureau of Land Management or by a decree of a Court of Law and/or that the corner points mentioned in lines 3, 4 and 5 above were in conformance with the rules of the Michigan Board of Land Surveyors or by a Decree of a Court of Law; established, re-established, monumented, re-monumented, recovered, found as expressed below:

NOTE: Not more than 4 corners, all in the same town and range, may be recorded on this certificate.

A. Description of original monument and accessories and/or subsequent restoration:

D - 1 NORTH 1/4 COR. SEC. 5
NO CORNER SET ON ORIGINAL SURVEY

B. Description of corner evidence found and/or method applied in restoring or reestablishing corner:

D - 1 NORTH 1/4 CORNER OF SEC. 5
FOUND NO EVIDENCE OF CORNER.
SET CORNER ON TOWNSHIP LINE BY SINGLE PROPORTION METHOD.

APPROVED BY
PEER GROUP

JUN 07 96


J.E.B.

S. 1/4 CORNER OF SEC. 32, T30N, R2E 9.9' WEST.

C. Description of monument for corner and accessories established to perpetuate locating the position of the corner:

D - 1 NORTH 1/4 COR. OF SEC. 5, T29N, R2E.
SET CONG. MONUMENT WITH REMON. CAP
N84°E 12"OAK 12.0'
S50°W 7"OAK 9.05'
N 5°E 5"OAK 16.80'
N70°E 7"MAPLE 21.35'

WITNESSES MARKED WITH 30 PENNY SPIKES & P.S. TAGS #18660
APPROVED BY PEER GROUP JUNE 7, 1996 AS A CAREFUL AND FAITHFUL ESTABLISHMENT
OF THE POSITION OF THE CORNER.

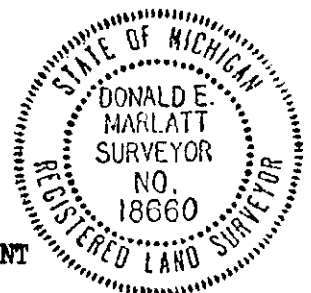

Signed by Donald E. Marlatt

Date 10/28/96

Surveyor's Michigan License No. 18660