

MAY 16 1997

COMMISSIONER

Montmorency County Remonumentation

Liber 00012 Page 0213

LAND CORNER RECORDATION CERTIFICATE  
Filing Requirement of Act 74, Mich. P.A. 1970

For corners in  
MONTMORENCY  
(County)

Located In: Corner Code #

STATE OF MICHIGAN  
MONTMORENCY COUNTY  
Recorded & Filed

11-01-1996 09:43:19

A. PANGAN-MCELROY  
REGISTER OF DEEDS

Register of Deeds Stamp & File Number

- ALBERT TWP.
- Public Land Survey T 29N R 2E E - 1
  - Property Controlling in Section S \_\_\_\_\_ T \_\_\_\_\_ R \_\_\_\_\_
  - Miscellaneous S \_\_\_\_\_ T \_\_\_\_\_ R \_\_\_\_\_
  - Property in Sec. S \_\_\_\_\_ T \_\_\_\_\_ R \_\_\_\_\_
  - Lot No. \_\_\_\_\_, Recorded Plat \_\_\_\_\_
  - Private Claims \_\_\_\_\_

	A	B	C	D	E	F	G	H	I	J	K	L	M
2	6		5		4		3		2		1		
3													
4	7		8		9		10		11		12		
5													
6	18		17		16		15		14		13		
7													
8	19		20		21		22		23		24		
9													
10	30		29		28		27		26		25		
11													
12	31		32		33		34		35		36		
13													

I, DONALD E MARLATT, in a field survey on MAY 30, 1996, do hereby certify that under requirements of P.A. 74, Michigan P.A. of 1970, the corner points mentioned in lines 1 and 2 above were in conformance with regulations and rules therefore as required in the current manual of survey instructions of the United States Department of the Interior, Bureau of Land Management or by a decree of a Court of Law and/or that the corner points mentioned in lines 3, 4 and 5 above were in conformance with the rules of the Michigan Board of Land Surveyors or by a Decree of a Court of Law; established, re-established, monumented, re-monumented, recovered, found as expressed below:

NOTE: Not more than 4 corners, all in the same town and range, may be recorded on this certificate.

A. Description of original monument and accessories and/or subsequent restoration:

E - 1 NORTH CORNER COMMON TO SEC'S 4 & 5  
 CORNER SET BY LEWIS CLASON 3-20-1839  
 ASPEN 6"-S71°W-8, ASPEN 8"-S47°E-23  
 D. PORTER SURVEY L. 1, P. 280, 2/2/1973. FOUND CONC. MONUMENT & WIT.MON. N45°W & N45°E 50'.  
 ACT 74 BY KEN OSTLING L. 1, P. 203, 3-1-1978. LEFT CONC. MONUMENT IN PLACE. SET CEDAR POST.  
 DNR SURVEY SEPT. 1977. 22"R. PINE S25°W 9.9'  
 12"OAK N83°E 30.0'  
 R.PINE STP. S77°E 18.55' (OLD FACE)

B. Description of corner evidence found and/or method applied in restoring or reestablishing corner:

E - 1 NORTH CORNER COMMON TO SEC'S 4 & 5. FOUND CONC. MONUMENT.  
 S80°W 28"OAK 46.2' EX.  
 S22°W 28"N.PINE 10.45' EX.  
 S75°E 12"PINE STP. 18.65' BLAZE  
 N85°E 16"OAK 30.38'

S.W. COR. SEC. 33, T30N, R2E 13.2'WEST.

NO EVIDENCE OF ORIGINAL CORNER

APPROVED BY  
PEER GROUP


JUN 07 96

J.E.B.

C. Description of monument for corner and accessories established to perpetuate locating the position of the corner:

E - 1 NORTH CORNER COMMON TO SEC'S 4 & 5, T29N, R2E.  
 PLACED REMON. CAP ON CONC. MONUMENT.  
 S80°W 28"OAK 46.2'  
 S22°W 28"N.PINE 10.45'  
 S75°E 12"PINE STP. 18.65'  
 N85°E 16"OAK 30.38'

WITNESSES MARKED WITH 30 PENNY SPIKES & P.S. TAGS #18660  
 APPROVED BY PEER GROUP JUNE 7, 1996 AS THE BEST AVAILABLE EVIDENCE OF THE POSITION OF THE ORIGINAL CORNER.

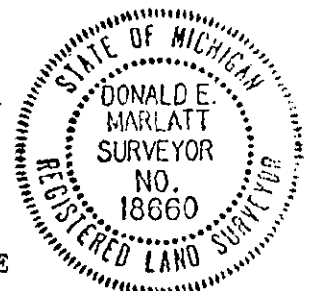

Signed by Donald E Marlatt Date 10/28/96  
 Surveyor's Michigan License No. 18660