

MAY 16 1997

COMMISSION

Montmorency County Remonumentation

Liber 00012 Page 0215

LAND CORNER RECORDATION CERTIFICATE

Filing Requirement of Act 74, Mich. P.A. 1970

For corners in MONTMORENCY

(County)

ALBERT TWP.

Located in:

Corner Code #

Table with 3 columns: Survey Type, Located in (S/T, R/E), and Corner Code #. Includes entries for Public Land Survey, Property Controlling in Section, and Miscellaneous Property in Sec.

STATE OF MICHIGAN MONTMORENCY COUNTY Recorded & Filed

11-01-1996 09:43:38

A. PANGAN-MCELROY REGISTER OF DEEDS

Register of Deeds Stamp & File Number

4. Lot No. , Recorded Plat
5. Private Claims

Grid table with columns A-L and rows 2-13. A dot is marked at the intersection of column G and row 3.

I, DONALD E MARLATT, in a field survey on MAY 30, 1996

do hereby certify that under requirements of P.A. 74, Michigan P.A. of 1970, the corner points mentioned in lines 1 and 2 above were in conformance with regulations and rules therefore as required in the current manual of survey instructions of the United States Department of the Interior, Bureau of Land Management or by a decree of a Court of Law and/or that the corner points mentioned in lines 3, 4 and 5 above were in conformance with the rules of the Michigan Board of Land Surveyors or by a Decree of a Court of Law; established, re-established, monumented, re-monumented, recovered, found as expressed below:

NOTE: Not more than 4 corners, all in the same town and range, may be recorded on this certificate.

A. Description of original monument and accessories and/or subsequent restoration:

G - 1 NORTH CORNER COMMON TO SEC'S 3 & 4 CORNER SET LEWIS CLASON 3-20-1839 Y. PINE 30"-S49°W-52, Y. PINE 18"-S48°E-60 G.F. DELAMATER 1940(NO COR. DESCRIPTION) FRANK SMITH FIELD BOOK 1946, FOUND CEMENT POST BY ROUSE. LEO SMITH 1960(NO COR. DESCRIPTION). LETTER IN FILE. D.E. MARLATT SURVEY L. 2, P. 78, 1975, FOUND CONC. MONUMENT. (ACT 74 BY KEN OSTLING L. 1, P. 203) FRED KING L. 4, P. 10, 8-7-1991 FOUND CONC. MONUMENT. NO WIT DNR SURVEY 1977, FOUND CONC. MON. (SEE RECORD WIT. BELOW) L. BEAUREGARD L. 10004, P. 290, 9-11-95. FOUND CONC. MONUMENT 1992. NO WITNESSES.

B. Description of corner evidence found and/or method applied in restoring or reestablishing corner:

G.- 1 NORTH CORNER COMMON TO SEC'S 3 & 4 FOUND CONC. MONUMENT S41°E CONC. MONUMENT 50.02' (S45°E CONC. MON. 50' -R) N87°W 30" OAK 31.82' S45°W CONC. MONUMENT 65' (R-65.1') S15°W 15"N. PINE 6.3' (R-8"R. PINE S30°W 5.6')

APPROVED BY PEER GROUP

JUN 07 96


Signature of D.E. Marlatt

S.W. COR. SEC. 34, T30N, R2E 19.1' WEST

NO EVIDENCE OF ORIGINAL COR.

C. Description of monument for corner and accessories established to perpetuate locating the position of the corner:

G - 1 NORTH CORNER COMMON TO SEC'S 3 & 4, T29N, R2E. PLACED REMON. CAP OF CONC. MONUMENT S80°E 15" OAK 40.14' S41°E CONC. MONUMENT 50.02' S15°W 15"N. PINE 6.3' N87°W 30" OAK 31.82' S45°W CONC. MONUMENT 65'

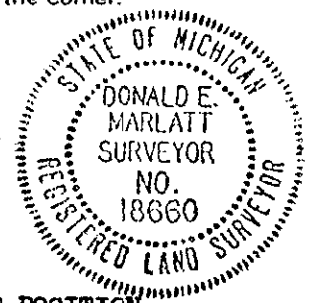

WITNESSES MARKED WITH 30 PENNY SPIKES & P.S. TAGS 18660. APPROVED BY PEER GROUP JUNE 7, 1996 AS THE BEST AVAILABLE EVIDENCE OF THE POSITION OF THE ORIGINAL CORNER.

Signed by Donald E Marlatt

Date 10/28/96

Surveyor's Michigan License No. 18660