

MAY 16 1997

Montmorency County Remonumentation

Liber 00012 Page 0216

COMMISSION

LAND CORNER RECORDATION CERTIFICATE
Filing Requirement of Act 74, Mich. P.A. 1970

For corners in

MONTMORENCY

(County)

ALBERT TWP.

Located In:

Corner Code =#

1. Public Land Survey

T 29N R 2E

H - 1

2. Property Controlling in Section

S T R

3. Miscellaneous

S T R

STATE OF MICHIGAN MONTMORENCY COUNTY Recorded & Filed

11-01-1996 09:43:48

A. PANGAN-MCELROY REGISTER OF DEEDS

Register of Deeds Stamp & File Number

4. Lot No. , Recorded Plat

5. Private Claims

Grid table with columns A-M and rows 1-13. A dot is marked at the intersection of column H and row 1.

DONALD E MARLATT

MAY 30, 1996

I, DONALD E MARLATT, in a field survey on MAY 30, 1996, do hereby certify that under requirements of P.A. 74, Michigan P.A. of 1970, the corner points mentioned in lines 1 and 2 above were in conformance with regulations and rules therefore as required in the current manual of survey instructions of the United States Department of the Interior, Bureau of Land Management or by a decree of a Court of Law and/or that the corner points mentioned in lines 3, 4 and 5 above were in conformance with the rules of the Michigan Board of Land Surveyors or by a Decree of a Court of Law; established, re-established, monumented, re-monumented, recovered, found as expressed below:

NOTE: Not more than 4 corners, all in the same town and range, may be recorded on this certificate.

A. Description of original monument and accessories and/or subsequent restoration:

H - 1 NORTH 1/4 COR. SEC. 3
NO CORNER SET ON ORIGINAL SURVEY
G.F. DELAMATER SURVEY 1940, NO CORNER DESCRIPTION.
LEO SMITH SURVEY 1960, NO CORNER DESCRIPTION. LETTER IN FILE.
AVERY LAKE SHORES SUB. APRIL 1965
HENNING SURVEY NOV. 1975, NO CORNER DESCRIPTION
ACT 74 BY KEN OSTLING L. 1, P. 203, 3-1-1978. SET DNR MONUMENT 1977.
DNR SURVEY, SEPT 1977- DNR MONUMENT.

WITNESSES
7"OAK S52°E 26.4'
10"OAK S83°E 16.85'
SET RED TOP POST

B. Description of corner evidence found and/or method applied in restoring or reestablishing corner:

H - 1 NORTH 1/4 COR. SEC. 3
FOUND DNR MONUMENT
S52°E 10"OAK 26.57' NBT
S83°E 15"OAK 17.04' NBT

APPROVED BY PEER GROUP


JUN 07 96

Handwritten signature

S. 1/4 COR. SEC. 34, T30N, R2E 19.4' WEST

C. Description of monument for corner and accessories established to perpetuate locating the position of the corner:

H - 1 NORTH 1/4 COR. OF SEC. 3, T29N, R2E.
LEFT DNR MONUMENT IN PLACE (1"PIPE & 4"CAP)
S10°E 7"POPLAR 33.47'
S50°E 10"MAPLE 26.57'
S82°E 15"OAK 17.04'
N35°E 4"MAPLE 49.75'

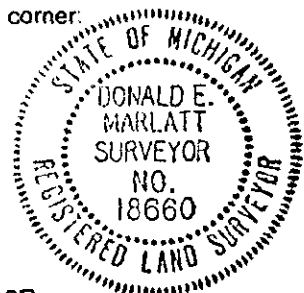

WITNESSES MARKED WITH 30 PENNY SPIKES & P.S. TAG # 18660
APPROVED BY PEER GROUP JUNE 7, 1996 AS A CAREFUL AND FAITHFUL ESTABLISHMENT OF THE POSITION OF THE CORNER.

Signed by Donald E Marlatt

Date 10-28-1996

Surveyor's Michigan License No. 18660