

MAY 16 1997

COMMISSIONER

LAND CORNER RECORDATION CERTIFICATE
Filing Requirement of Act 74, Mich. P.A. 1970

For corners in

Table with columns: MONTMORENCY (County), Located In: (Township, Range, Section), Corner Code. Includes entries for Public Land Survey and Property Controlling in Section.

STATE OF MICHIGAN
MONTMORENCY COUNTY
Recorded & Filed

11-01-1996 09:44:07

A. PANGAN-MCELROY
REGISTER OF DEEDS

Register of Deeds Stamp & File Number

- 4. Lot No. , Recorded Plat
5. Private Claims

Grid table with columns A-L and rows 2-13. A small circle is marked in the intersection of column J and row 11.

DONALD E MARLATT, in a field survey on MAY 30, 1996, do hereby certify that under requirements of P.A. 74, Michigan P.A. of 1970, the corner points mentioned in lines 1 and 2 above were in conformance with regulations and rules therefore as required in the current manual of survey instructions of the United States Department of the Interior, Bureau of Land Management or by a decree of a Court of Law and/or that the corner points mentioned in lines 3, 4 and 5 above were in conformance with the rules of the Michigan Board of Land Surveyors or by a Decree of a Court of Law; established, re-established, monumented, re-monumented, recovered, found as expressed below:

NOTE: Not more than 4 corners, all in the same town and range, may be recorded on this certificate.

A. Description of original monument and accessories and/or subsequent restoration:

J - 1 NORTH 1/4 COR. SEC. 2
NO CORNER SET ON ORIGINAL SURVEY
ACT 74 BY KENNETH OSTLING L. 1, P.204, 3-1-78 . SET DNR MONUMENT. SET BY S.P. METHOD.
DNR SURVEY SEPT. 1977
WITNESSES
3"J PINE S31°W 18.35'
3"J PINE S10°E 56.15'
18"R PINE S87°E 119.15'
SET RED TOP POST

B. Description of corner evidence found and/or method applied in restoring or reestablishing corner:

J - 1 NORTH 1/4 COR. OF SEC. 2
FOUND DNR MONUMENT.
S33°W 11"J.PINE 18.25'
N55°W 12"J.PINE 28.23' J.L.S. TAG #26466
N25°W 12"POPLAR 15.97' " " "
WEST 12"J.PINE 13.2' " " "
S. 1/4 COR. SEC. 35, T30N, R2E 9.43' WEST

APPROVED BY
PEER GROUP


JUN 07 96

Signature of J.E.B.

C. Description of monument for corner and accessories established to perpetuate locating the position of the corner:

J - 1 NORTH 1/4 COR. OF SEC. 2, T29N, R2E.
LEFT DNR MONUMENT IN PLACE (1"PIPE WITH 4"CAP)
N25°W 12"POPLAR 15.97'
N55°W 12"J.PINE 28.23'
WEST 12"J.PINE 13.2'
N26°W 8"PINE STP. 24.0' BLAZE

WITNESSES MARKED WITH 30 PENNY SPIKES & P.S. TAG 18660
APPROVED BY PEER GROUP JUNE 7, 1996 AS A CAREFUL AND FAITHFULL ESTABLISHMENT OF OF THE POSITION OF THE CORNER.

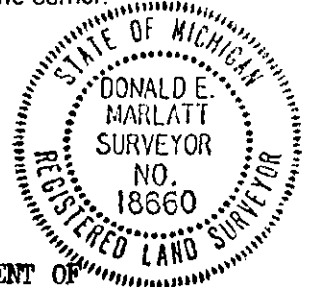

Signed by Donald E Marlatt
Surveyor's Michigan License No. 18660

Date 10-28-1996