

Mountmexway Co.

# LAND CORNER RECORDATION CERTIFICATE

## FILING REQUIREMENT OF ACT 74, MICH. P.A.1970

FOR CORNERS OF--	LOCATED IN--	CORNER CODE NUMBER
1. PUBLIC LAND SURVEY	T. <u>29</u> N. S., R. <u>3</u> <del>W.</del>	B-13 C-13 E-13
2. PROPERTY CONTROLLING IN SECTION	, T. _____ N. S., R. _____ E. W.	_____
3. MISCELLANEOUS PROPERTY IN SECTION	, T. _____ N. S., R. _____ E. W.	_____
4. LOT NO. _____, RECORDED PLAT _____		
5. PRIVATE CLAIMS _____		

REGISTER OF DEEDS STAMP AND FILING NUMBER

I, Kenneth J. Ostling do hereby certify that under requirements of P.A. 74, Michigan P.A. of 1970, the corner points mentioned in lines 1 and 2 above (identified with circles on index code diagram - over) were, in a field survey on 11-1- 1972, established, re-established, monumented, re-monumented, recovered or restored as expressed below and in conformance with regulations and rules therefore as required in the current manual of survey instructions of the United States Department of the Interior, Bureau of Land Management or by a decree of a court of law. Furthermore, that the corner points mentioned in lines 3, 4 and 5 above were, in a field survey on \_\_\_\_\_ 19\_\_\_\_, found, recovered, restored, established or re-established as expressed below and in conformance with the rules of the Michigan State Board of Registration for Land Surveyors or, by a Decree of a Court of law:

A. Description of original monument and accessories and/or subsequent restoration:


B. Description of corner evidence found and/or method applied in restoring or re-establishing corner:

- B-13 Set corner by proportionate measurement between section corners.
- C-13 Set corner from remains of probable U.S.B.T. stump. Fits good for measurement to closing corner and section corners East and West.
- E-13 Set corner at average alignment of roads East and South, which falls about in line with old fence line North, and fits quite well for proportionate measure.

C. Description of monument for corner and accessories established to perpetuate locating the position of the corner:

B-13	C-13	E-13
Set DNR Monument	Set DNR Monument	Set DNR Mon. & Cedar Post
3" R.Oak N18E 38.8'	J. Pine N65W 29.9'	7" Maple N60E 29.5'
7" R. Oak N83W 34.9'	9" R. Pine N09E 86.8'	7" Maple N28W 48.2'
Sec. 5 1/4 cor East 7.9'	Cor 5-6 East 7.9'	Cor. 4-5 West 7.9'
	R.P. Stp N45W 9.2'	
	(OBT)	

SIGNED BY Kenneth J. Ostling DATE \_\_\_\_\_  
 SURVEYOR'S MICHIGAN REGISTRATION NO. 10068

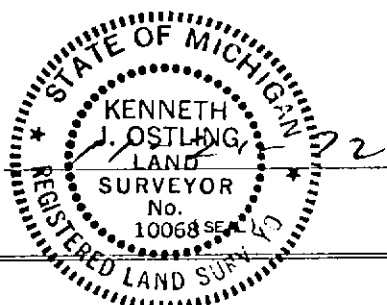

FOR STATE AND UNITED STATES AGENCIES:

SIGNED BY \_\_\_\_\_ DATE \_\_\_\_\_  
CHIEF OF SURVEY PARTY

APPROVED AND SIGNED BY \_\_\_\_\_ DATE \_\_\_\_\_  
MICHIGAN REGISTERED LAND SURVEYOR (SEAL)

SURVEYOR'S MICHIGAN REGISTRATION NO. \_\_\_\_\_