

**LAND CORNER RECORDATION CERTIFICATE**  
**Filing Requirement of Act 74, Mich. P.A. 1970**

For corners in

<u>Montmorency</u> <small>(County)</small>	Located In:	Corner Code #/1
1. Public Land Survey	T <u>29N</u> R <u>3E</u>	E-12
	T <u>29N</u> R <u>3E</u>	D-12
	T _____ R _____	_____
	T _____ R _____	_____
2. Property Controlling in Section	S <u>32</u> T <u>29N</u> R <u>3E</u>	6
	S <u>32</u> T <u>29N</u> R <u>3E</u>	7
3. Miscellaneous Property in Sec.	S _____ T _____ R _____	_____
	S _____ T _____ R _____	_____

Register of Deeds Stamp & File Number

4. Lot No. \_\_\_\_\_, Recorded Plat \_\_\_\_\_  
 5. Private Claims \_\_\_\_\_

I, Carl R. Johnson, in a field survey on November 13, 1990, do hereby certify that under requirements of P.A. 74, Michigan P.A. of 1970, the corner points mentioned in lines 1 and 2 above were in conformance with regulations and rules therefore as required in the current manual of survey instructions of the United States Department of the Interior, Bureau of Land Management or by a decree of a Court of Law and/or that the corner points mentioned in lines 3, 4 and 5 above were in conformance with the rules of the Michigan Board of Land Surveyors or by a Decree of a Court of Law; established, re-established, monumented, re-monumented, recovered, found as expressed below:


**NOTE: Not more than 4 corners, all in the same town and range, may be recorded on this certificate.**

	A	B	C	D	E	F	G	H	I	J	K	L	M
2	6	5	4	3	2	1							
3													
4	7	8	9	10	11	12							
5													
6	18	17	16	15	14	13							
7													
8	19	20	21	22	23	24							
9													
10	30	29	28	27	26	25							
11													
12	31	32	33	34	35	36							
13													

A. Description of original monument and accessories and/or subsequent restoration:

B. Description of corner evidence found and/or method applied in restoring or reestablishing corner:

- E-12 - Set by single proportionate measurement between section corners. No evidence of original or subsequent corner.
- D-12 - Set at true computed intersection of 1/4 lines.
- 6 - Set by standard survey procedure for subdivision of a section.
- 7 - Set by standard survey procedure for subdivision of a section.

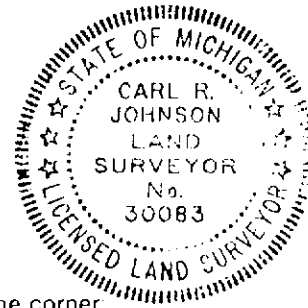

C. Description of monument for corner and accessories established to perpetuate locating the position of the corner.

<u>E-12 - E 1/4 Corner Sec. 32</u> DNR Mon & Cedar Post Maple 8" S13°W 26.9 ft Twin Maple 6" S68°W 33.4 ft Triple Maple 6" N17°W 11.2 ft Ironwood 10" N52°E 19.7 ft Fence Corner Post S56°E 21.8 ft	<u>D-12 - Center of Section</u> DNR Mon & Cedar Post Maple 8" Due North 14.7 ft Maple 8" N55°W 24.9 ft Beech 5" S70°W 13.7 ft Cherry 3" S35°E 7.8 ft	<u>6 - Center of NE 1/4</u> 5/8" Bar w/cap Maple 6" S26°E 20.0 ft Maple 6" S17°W 8.1 ft Maple 6" N29°W 28.4 ft Maple 6" N42°E 32.6 ft
	<u>7 - N 1/8 Cor on E. Side of Sec.</u> 5/8" Bar w/cap Ironwood 5" S37°W 17.6 ft Twin Maple 14" N3°E 37.1 ft Maple 8" N50°E 28.2 ft Maple 8" S62°E 21.3 ft	

Signed by Carl R. Johnson  
 Surveyor's Michigan License No. 30083

Date 1/14/91