

MAY 16 1997

COMMISSION

Montmorency County Re-monumentation

LAND CORNER RECORDATION CERTIFICATE
Filing Requirement of Act 74, Mich. P.A. 1970

STATE OF MICHIGAN
MONTMORENCY COUNTY
Recorded & Filed

09-27-1996 13:27:32

For corners in

Montmorency (County)	Located In: Loud Township	Corner Code # C-1
1. Public Land Survey	T 29N R 3E	_____
	T _____ R _____	_____
	T _____ R _____	_____
	T _____ R _____	_____
2. Property Controlling in Section	S _____ T _____ R _____	_____
	S _____ T _____ R _____	_____
3. Miscellaneous Property in Sec.	S _____ T _____ R _____	_____
	S _____ T _____ R _____	_____
4. Lot No. _____, Recorded Plat _____		
5. Private Claims _____		

A. PANGAN-MCELROY
REGISTER OF DEEDS

Liber 00012 Page 0203

Register of Deeds Stamp & File Number

I, Larry G. Beauregard, in a field survey on June, 1996, do hereby certify that under requirements of P.A. 74, Michigan P.A. of 1970, the corner points mentioned in lines 1 and 2 above were in conformance with regulations and rules therefore as required in the current manual of survey instructions of the United States Department of the Interior, Bureau of Land Management or by a decree of a Court of Law and/or that the corner points mentioned in lines 3, 4 and 5 above were in conformance with the rules of the Michigan Board of Land Surveyors or by a Decree of a Court of Law; established, re-established, monumented, re-monumented, recovered, found as expressed below:

A	B	C	D	E	F	G	H	I	J	K	L	M
2	6	5	4	3	2	1						
3												
4	7	8	9	10	11	12						
5												
6	18	17	16	15	14	13						
7												
8	19	20	21	22	23	24						
9												
10	30	29	28	27	26	25						
11												
12	31	32	33	34	35	36						
13												

NOTE: Not more than 4 corners, all in the same town and range, may be recorded on this certificate.

- C-1 Corner common to Sections 5 & 6
- A. Description of original monument and accessories and/or subsequent restoration:
 - 1839 - Lewis Clawson D.S. intersected North bdy. 10 links East of post. Set post Wit's marked: (S 54° E 24" Y. Pine 57 links) (S 35° W 24" Y. Pine 81 links).
 - 1960 - Dean DeLaMater P.S # 05778, (DOC) Department Of Conservation surveyor set 1" pipe with 4" brass cap. Wit's marked: (S 49° E 9" Aspen 25.5 links) (S 89° W 10" Aspen 78 links).
 - 1977 - Donald E. Marlatt P.S. # 18660 found DOC corner. Filed Act 74 Rec. L. 1 P. 213 wit's recorded: (N 50° W 13.25' 8" Poplar) (West 52.8' 15" Poplar NBT).

- B. Description of corner evidence found and/or method applied in restoring or reestablishing corner:
 - I. Found DOC corner set by DeLaMater in good condition & one wit's by Marlatt.
- This corner is 6.6' East of std. cor. for Sec. 31 & 32, T 30N, R 3E.


APPROVED BY
PEER GROUP

Jul. 12 96
L.G.B.

- C. Description of monument for corner and accessories established to perpetuate locating the position of the corner:
 - C-1 Corner common to Sections 5 & 6
 - 1" pipe with 4" brass cap. Accepted as the best available evidence of the position of the original corner. Approved by the Peer Group on July 12, 1996.

West 6.6' 1" pipe with 4" brass cap std. cor. Sec. 31 & 32, T 30N, R 3E
 N 35° W 13.8' 9" Poplar (M) N 50° W 13.25' 8" Poplar (R)
 N 55° W 29.44' 11" Poplar
 N 75° W 59.0' 10" Poplar
 S 55° W 7.00' 5" Poplar

Placed 60d penny spike, P.S. tag # 18654 & blaze. (typ)

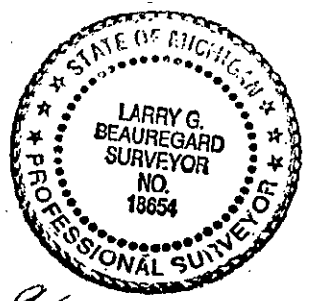

Signed by Larry G. Beauregard Date 9-24-96
 Surveyor's Michigan License No. 18654