

Montmorency County Remonumentation

Liber 00012 Page 0176

LAND CORNER RECORDATION CERTIFICATE
Filing Requirement of Act 74, Mich. P.A. 1970

For corners in

Montmorency (County)	Located In:	Corner Code ##
	LOUD TWP.	
1. Public Land Survey	T 29N R 3E	J-1
	T ___ R ___	_____
	T ___ R ___	_____
	T ___ R ___	_____
2. Property Controlling in Section	S ___ T ___ R ___	_____
	S ___ T ___ R ___	_____
3. Miscellaneous Property in Sec.	S ___ T ___ R ___	_____
	S ___ T ___ R ___	_____

STATE OF MICHIGAN
MONTMORENCY COUNTY
Recorded & Filed

11-21-1995 13:21:42

A. PANGAN-MCELROY
REGISTER OF DEEDS

Register of Deeds Stamp & File Number

4. Lot No. _____, Recorded Plat _____
5. Private Claims _____

	A	B	C	D	E	F	G	H	I	J	K	L	M
2	6	5	4	3	2	1							
3													
4	7	8	9	10	11	12							
5													
6	18	17	16	15	14	13							
7													
8	19	20	21	22	23	24							
9													
10	30	29	28	27	26	25							
11													
12	31	32	33	34	35	36							
13													

I, Donald E. Marlatt, in a field survey on 3-31, 19 95, do hereby certify that under requirements of P.A. 74, Michigan P.A. of 1970, the corner points mentioned in lines 1 and 2 above were in conformance with regulations and rules therefore as required in the current manual of survey instructions of the United States Department of the Interior, Bureau of Land Management or by a decree of a Court of Law and/or that the corner points mentioned in lines 3, 4 and 5 above were in conformance with the rules of the Michigan Board of Land Surveyors or by a Decree of a Court of Law; established, re-established, monumented, re-monumented, recovered, found as expressed below:

NOTE: Not more than 4 corners, all in the same town and range, may be recorded on this certificate.


A. Description of original monument and accessories and/or subsequent restoration:

- (J-1) N. 1/4 corner of Section 2, T 29 N, R 3 E.
None. NO COR. SET ON ORIGINAL SURVEY.

SURVEY &
REMONUMENTATION
DEC 18 1995
COMMISSION

B. Description of corner evidence found and/or method applied in restoring or reestablishing corner:

- (J-1) N. 1/4 corner of Section 2, T 29 N, R 3 E.
Set concrete monument & remonumentation cap by S.P. method.
S. 1/4 corner of Section 35, T 30 N, R 3 E, 3.31' West.

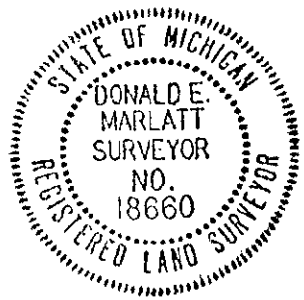

C. Description of monument for corner and accessories established to perpetuate locating the position of the corner:

- (J-1) N. 1/4 corner of Section 2, T 29 N, R 3 E.
Set concrete monument & remonumentation cap. #18660
S 03* E 7" W. Pine 32.02'
S 49* W 8" Maple 34.03'
N 30* W 15" Spruce 49.14'
N 15* E 15" Poplar 67.8'
Witnesses marked with a 30" penny spike & P.S. tag #18660.
Approved by the Peer Group on June 2, 1995 as a careful and faithful establishment of the position of the corner.

APPROVED BY
PEER GROUP

JUN 02 95

[Signature]

Signed by Donald E. Marlatt Date 7-11-1995
Surveyor's Michigan License No. 18660