

Montmorency County Remonumentation

LAND CORNER RECORDATION CERTIFICATEiber 00012 Page 0177
 Filing Requirement of Act 74, Mich. P.A. 1970

For corners in

<u>MONTMORENCY</u> (County)	Located In: LOUD TWP.	Corner Code ## K-1
1. Public Land Survey	T <u>29N</u> R <u>3E</u>	<u>K-1</u>
	T _____ R _____	_____
	T _____ R _____	_____
	T _____ R _____	_____
2. Property Controlling in Section	S _____ T _____ R _____	_____
	S _____ T _____ R _____	_____
3. Miscellaneous Property in Sec.	S _____ T _____ R _____	_____
	S _____ T _____ R _____	_____
4. Lot No. _____, Recorded Plat _____		
5. Private Claims _____		

STATE OF MICHIGAN
 MONTMORENCY COUNTY
 Recorded & Filed

11-21-1995 13:21:52

A. PANGAN-MCELROY
 REGISTER OF DEEDS

Register of Deeds Stamp & File Number

I, DONALD E MARLATT, in a field survey on 4-24, 19 95, do hereby certify that under requirements of P.A. 74, Michigan P.A. of 1970, the corner points mentioned in lines 1 and 2 above were in conformance with regulations and rules therefore as required in the current manual of survey instructions of the United States Department of the Interior, Bureau of Land Management or by a decree of a Court of Law and/or that the corner points mentioned in lines 3, 4 and 5 above were in conformance with the rules of the Michigan Board of Land Surveyors or by a Decree of a Court of Law; established, re-established, monumented, re-monumented, recovered, found as expressed below:

NOTE: Not more than 4 corners, all in the same town and range, may be recorded on this certificate.

	A	B	C	D	E	F	G	H	I	J	K	L	M
2	6	5	4	3	2	1							
3													
4	7	8	9	10	11	12							
5													
6	18	17	16	15	14	13							
7													
8	19	20	21	22	23	24							
9													
10	30	29	28	27	26	25							
11													
12	31	32	33	34	35	36							
13													

A. Description of original monument and accessories and/or subsequent restoration:

K-1 NORTH CORNER COMMON TO SECTIONS 1 & 2, T29N, R3E
 POST SET BY LEWIS CLASON 1840. S29°E 6" FIR 32 LINKS-S50°W 12" CEDAR 25 LINKS.
 FRANK SMITH NOTES 12-5-43 FOUND 1½" PIPE N65°W 60.55' P. POLE-N22°E 87.95' 12" POPLAR-N87°E 26.57' T. POLE.
 MSHD WIT. N.C. CALDWELL FOUND 1½" PIPE 1-7-65. N66°W 60.74' P. POLE-N61°E 45' T. POLE-S62°E 85.03' 8" CEDAR.
 R.S. SCOTT ENG. SURVEY 8-23-71-FOUND EXISTING IRONS-NO WIT.
 R.S. SCOTT ENG. SURVEY 1-7-75. FOUND IRON BAR IN MONUMENT BOX-NO WIT. MARKED.
 R.S. SCOTT ASSOC. ACT 74 BY L. BEAUREGARD L. 1, P. 346.
 R.S. SCOTT ASSOC. SURVEY 1-5-94. L. 4, P. 156-FOUND ½" BAR IN MON. BOX (SEE BELOW)

B. Description of corner evidence found and/or method applied in restoring or reestablishing corner:


K-1 NORTH CORNER COMMON TO SEC'S 1 & 2, T29N, R3E. S70°W 93.25' 6" WILLOW
 FOUND ½" ROD IN MONUMENT BOX (M-33) N75°E 78.6' T. POLE
 N66°W 92.17' P. POLE

SURVEY &
 REMONUMENTATION

No evidence of original corner

DEC 18 1995

COMMISSION

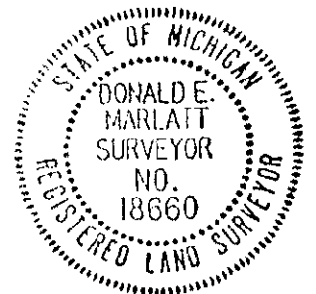

C. Description of monument for corner and accessories established to perpetuate locating the position of the corner:

K-1 NORTH CORNER COMMON TO SEC'S 1 & 2, T29N, R3E.
 PLACED REMON. CAP ON ½" ROD #18660
 N75°E 12" SPRUCE 68.48'
 N52°W P. POLE 92.20'
 S78°W 15" WILLOW 98.25'
 N40°E 18" SPRUCE 123.75'
 WITNESSES MARKED WITH 30 PENNY SPIKES & P.S. TAG #18660
 APPROVED BY THE PEER GROUP ON JUNE 2, 1995 AS THE BEST AVAILABLE EVIDENCE OF THE POSITION OF THE ORIGINAL CORNER.

APPROVED BY
 PEER GROUP

JUN 02 95

LYB

Signed by Donald E Marlatt

Date 11-17-1995

Surveyor's Michigan License No. 18660