

LAND CORNER RECORDATION CERTIFICATE

Filing Requirement of Act 74, Mich. PA 1970

For Corners In: Montmorency Located In _____ Corner Code # _____
(County)

1. Public Land Survey	T _____	R _____	_____
	T _____	R _____	_____
2. Property Controlling in Section	S <u>23</u>	T <u>29N</u>	R <u>3E</u> <u>1</u>
	S <u>23</u>	T <u>29N</u>	R <u>3E</u> <u>3</u>
3. Miscellaneous Property in Section	S _____	T _____	R _____
	S _____	T _____	R _____


4. Lot No: _____ Recorded Plat: _____

5. Private Claims: _____

I, Carl T. Kiiskila, in a field survey on March 31, 1999 do hereby state that under requirements of PA 74, Michigan PA of 1970, the corner points mentioned in lines 1 and 2 above were in conformance with regulations and rules therefore as required in the current manual of survey instructions of the United States Department of the Interior, Bureau of Land Management or by a decree of a Court of Law and/or that the corner points mentioned in lines 3, 4 and 5 above were in conformance with the rules of the Michigan Board of Land Surveyors or by a Decree of a Court of Law; established, re-established, monumented, recovered, found as expressed below:

NOTE: Not more than 2 corners, all in the same town and range, may be recorded on this certificate.

Register of Deeds Stamp & File Number

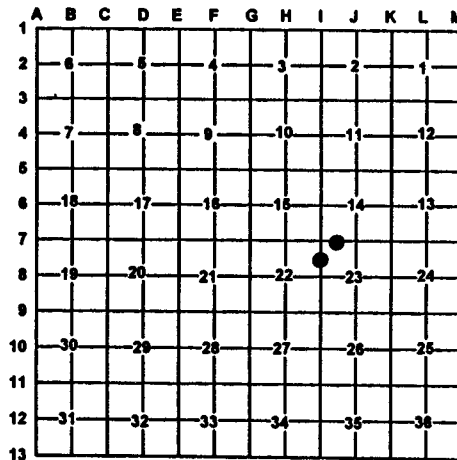

A. Description of original monument and accessories and/or subsequent restoration:

1 - This position was not established during the original government survey.

3 - This position was not established during the original government survey.



B. Description of corner evidence found and/or method applies in restoring or re-establishing corner:

1 - Found and accepted a 1/2" rod in a monument box, set by Norman Caldwell PS #12018.

3 - Established the Northwest corner of the Southwest quarter of the Northwest quarter of Section 23 per standard B.L.M. instructions for the subdivision of a section.

C. Description of monument for corner and accessories established to perpetuate locating the position of the corner:

1 - Found 1/2" rod in a monument box.

3 - Set 5/8" X 32" rerod with cap # 33981.

Wit: 1/2" rod & cedar post	North	50.01'
Utility pole	N 06° W	37.21'
6" Balsam	S 09° E	51.73'
10" White Pine	S 38° W	51.82'
Centerline of east-west blacktop County Road 612	North	0.8'

Wit: 3" & 5" twin Maple	N 16° E	16.87'
2" Maple	N 71° E	15.90'
5" Oak	S 06° W	26.89'
4" Balsam	N 77° W	38.92'
Centerline of north-south drive	West	16.8'

Signed by: Carl T. Kiiskila
Surveyor's Michigan License No.: 33981

Date: 5-26-99