

MAY 16 1997

COMMISSION

Montmorency County Remonumentation

LAND CORNER RECORDATION CERTIFICATE  
Filing Requirement of Act 74, Mich. P.A. 1970

STATE OF MICHIGAN  
MONTMORENCY COUNTY  
Recorded & Filed

09-27-1996 13:25:25

A. PANGAN-MCELROY  
REGISTER OF DEEDS

~~Liber 00007 Page 0194~~  
~~Liber 00001 Page 0194~~

Register of Deeds Stamp & File Number

For corners in

Montmorency (County)	Located In: Rust Township	Corner Code #
1. Public Land Survey	T 29N R 4E	H-13
	T R	
	T R	
	T R	
2. Property Controlling in Section	S T R	
	S T R	
3. Miscellaneous Property in Sec.	S T R	
	S T R	

- 4. Lot No. \_\_\_\_\_, Recorded Plat \_\_\_\_\_
- 5. Private Claims \_\_\_\_\_

	A	B	C	D	E	F	G	H	I	J	K	L	M
2	6	5	4	3	2	1							
3													
4	7	8	9	10	11	12							
5													
6	18	17	16	15	14	13							
7													
8	19	20	21	22	23	24							
9													
10	30	29	28	27	26	25							
11													
12	31	32	33	34	35	36							
13													

I, Larry G. Beauregard, in a field survey on June, 1996, do hereby certify that under requirements of P.A. 74, Michigan P.A. of 1970, the corner points mentioned in lines 1 and 2 above were in conformance with regulations and rules therefore as required in the current manual of survey instructions of the United States Department of the Interior, Bureau of Land Management or by a decree of a Court of Law and/or that the corner points mentioned in lines 3, 4 and 5 above were in conformance with the rules of the Michigan Board of Land Surveyors or by a Decree of a Court of Law; established, re-established, monumented, re-monumented, recovered, found as expressed below:

**NOTE: Not more than 4 corners, all in the same town and range, may be recorded on this certificate.**

A. Description of original monument and accessories and/or subsequent restoration:  
H-13 South 1/4 corner Section 34.

Nov. 1839 - Original post set by Lewis Clason D.S. Wit's marked: (N 53° E 16 links 5" Spruce Pine)  
(N 35° W 16 links 6" Spruce Pine).

No Act # 74 recorded.  
No Act # 132 recorded.

Liber 00012 Page 0194

B. Description of corner evidence found and/or method applied in restoring or reestablishing corner:

No corner found or original witnesses. Set 4" dia. x 36" conc. mon. & Re-mon cap # 18654 by S.P. method on County line, in line with old hunting wire laying on the ground.

West 11.57' Oscoda CO. std. corner. N 1/4 corner Section 3, T 28N, R 4E.



JUL. 12, 96

*L.G.B.*


C. Description of monument for corner and accessories established to perpetuate locating the position of the corner:

H-13 South 1/4 corner Section 34

4" dia. x 36" con. mon. & Re-mon cap # 18654. Accepted as a careful and faithful establishment of the position of the corner. Approved by the Peer Group on July 12, 1996.

South 18.5'± barbwire fence  
N 10° W 14.31' 10" J.Berry  
N 10° E 85.22' 20" R.Oak  
S 12° E 66.40' 15" R.Oak  
S 70° E 107.20' PK nail & PS tag on top of gate post.

Placed 60d penny spike, P.S. tag # 18654 & blaze. (typ)

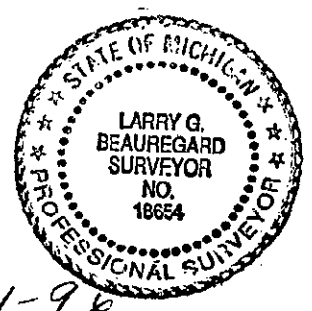

Signed by Larry G. Beauregard  
Surveyor's Michigan License No. 18654

Date 9-24-96