

LAND CORNER RECORDATION CERTIFICATE

FILING REQUIREMENT OF ACT 74, MICH. P.A.1970

FOR CORNERS OF--:	LOCATED IN--:	CORNER CODE NUMBER
1. PUBLIC LAND SURVEY	T. 30 N. R. 2 E.	F-11
2. PROPERTY CONTROLLING IN SECTION 28	T. 30 N. R. 2 E.	14; 16
3. MISCELLANEOUS PROPERTY IN SECTION	T. N. S. R. E. W.	
4. LOT NO. _____, RECORDED PLAT _____		
5. PRIVATE CLAIMS _____		

REGISTER OF DEEDS STAMP AND FILING NUMBER

I, Kenneth J. Ostling, do hereby certify that under requirements of P.A. 74, Michigan P.A. of 1970, the corner points mentioned in lines 1 and 2 above were, in a field survey on September 29, 1977, established, re-established, monumented, re-monumented, recovered or restored as expressed below and in conformance with regulations and rules therefore as required in the current manual of survey instructions of the United States Department of the Interior, Bureau of Land Management or by a decree of a court of law. Furthermore, that the corner points mentioned in lines 3, 4 and 5 above were, in a field survey on _____, 19____, found, recovered, restored, established or re-established as expressed below and in conformance with the rules of the Michigan State Board of Registration for Land Surveyors or, by a Decree of a Court of law:

A. Description of original monument and accessories and/or subsequent restoration:

B. Description of corner evidence found and/or method applied in restoring or re-establishing corner:


- F-11 Set corner by proportionate measurement, midpoint on line, between section corners. Falls in line with fences north and south.
- 14 Set by standard survey procedures for the subdivision of sections.
- 16 Set corner by standard procedure for subdivision of sections. Falls about 3' E of fence line north.

C. Description of monument for corner and accessories established to perpetuate locating the position of the corner:

	F-11	14	16
Set DNR monument		Set 5/8" Iron bar w/RLS cap	Set 5/8" rerod w/RLS cap
10" R. Pine N12°W	65.4	20" W. Oak N77°W	27.1
5" R. Pine N30°E	85.4	23" R. Oak N20°W	65.8
Cedar post North	20'		17" Oak N78°E 38.7
Center E-W Rd. South	6'		23" Oak N51°W 26.2
			Center E-W Rd. South 6'
			Cedar Post North 12'

SIGNED BY *Kenneth J. Ostling* DATE / /

SURVEYOR'S MICHIGAN REGISTRATION NO. 10068

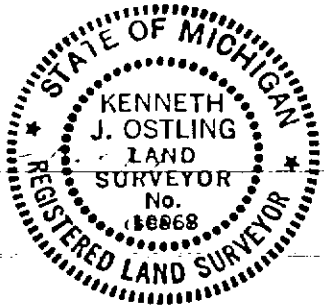

FOR STATE AND UNITED STATES AGENCIES:

SIGNED BY _____ DATE _____
CHIEF OF SURVEY PARTY

APPROVED AND SIGNED BY _____ DATE _____
MICHIGAN REGISTERED LAND SURVEYOR (SEAL)

SURVEYOR'S MICHIGAN REGISTRATION NO. _____
 BRILEY TOWNSHIP
 MONTMORENCY COUNTY

MAY PLACE SKETCH ON BACK OR ATTACHED SHEET