

LAND CORNER RECORDATION CERTIFICATE

FILING REQUIREMENT OF ACT 74, MICH. P.A.1970

FOR CORNERS OF--:	LOCATED IN--:	CORNER CODE NUMBER
1. PUBLIC LAND SURVEY-----	T. 30 ^{N.} , R. 2 ^{E.}	F-13 ✓
2. PROPERTY CONTROLL- ING IN SECTION-----	, T. _____, S., R. _____, E. W.	-----
3. MISCELLANEOUS PROPERTY IN SECTION-----	, T. _____, S., R. _____, E. W.	-----
4. LOT NO.-----, RECORDED PLAT-----		
5. PRIVATE CLAIMS-----		

REGISTER OF DEEDS STAMP AND
FILING NUMBER

I, KENNETH J. OSTLING, do hereby certify that under requirements of P.A. 74, Michigan P.A. of 1970, the corner points mentioned in lines 1 and 2 above were, in a field survey on JULY 19, _____, 1982, established, re-established, monumented, re-monumented, recovered or restored as expressed below and in conformance with regulations and rules therefore as required in the current manual of survey instructions of the United States Department of the Interior, Bureau of Land Management or by a decree of a court of law. Furthermore, that the corner points mentioned in lines 3, 4 and 5 above were, in a field survey on _____, 19____, found, recovered, restored, established or re-established as expressed below and in conformance with the rules of the Michigan State Board of Registration for Land Surveyors or, by a Decree of a Court of law:

A. Description of original monument and accessories and/or subsequent restoration:

B. Description of corner evidence found and/or method applied in restoring or re-establishing corner:

F-13 CORNER SET BY PROPORTIONATE MEASUREMENT BETWEEN SECTION CORNERS. THIS CORNER SET TO CORRECT 1977 CORNER SET IN ERROR.

C. Description of monument for corner and accessories established to perpetuate locating the position of the corner:

F-13
 RESET DNR MONUMENT
 6" R. MAPLE N69°E 27.1'
 5" W. OAK N13°E 28.7'
 6" R. OAK N47°W 11.1'
 N 1/4 SECTION 4 - EAST 16.20'


SIGNED BY *Kenneth J. Ostling* DATE 8/18/82

SURVEYOR'S MICHIGAN REGISTRATION NO. #10068

FOR STATE AND UNITED STATES AGENCIES:

SIGNED BY _____ DATE _____
CHIEF OF SURVEY PARTY

APPROVED AND SIGNED BY _____ DATE _____
MICHIGAN REGISTERED LAND SURVEYOR

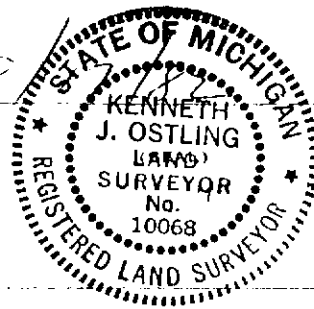

SURVEYOR'S MICHIGAN REGISTRATION NO. _____ MONTMORENCY COUNTY