

Montmorency County Remonumentation

Libel 12 Page 52

LAND CORNER RECORDATION CERTIFICATE
 Filing Requirement of Act 74, Mich. P.A. 1970

For corners in

<u>Montmorency</u> <small>(County)</small>	Located In:	Corner Code #
1. Public Land Survey	T <u>30N</u> R <u>2E</u>	<u>(A-2)</u>
	T _____ R _____	_____
	T _____ R _____	_____
	T _____ R _____	_____
2. Property Controlling in Section	S _____ T _____ R _____	_____
	S _____ T _____ R _____	_____
3. Miscellaneous Property in Sec.	S _____ T _____ R _____	_____
	S _____ T _____ R _____	_____
4. Lot No. _____, Recorded Plat _____		
5. Private Claims _____		

RECEIVED
 MONTMORENCY CITY
 REGISTER OF DEEDS
 DEC 28 9 05 AM '93
A. PANGAR-MCELROY

Register of Deeds Stamp & File Number

I, Larry G. Beauregard, in a field survey on October, 19 93, do hereby certify that under requirements of P.A. 74, Michigan P.A. of 1970, the corner points mentioned in lines 1 and 2 above were in conformance with regulations and rules therefore as required in the current manual of survey instructions of the United States Department of the Interior, Bureau of Land Management or by a decree of a Court of Law and/or that the corner points mentioned in lines 3, 4 and 5 above were in conformance with the rules of the Michigan Board of Land Surveyors or by a Decree of a Court of Law; established, re-established, monumented, re-monumented, recovered, found as expressed below:

NOTE: Not more than 4 corners, all in the same town and range, may be recorded on this certificate.


	A	B	C	D	E	F	G	H	I	J	K	L	M
2	6	5	4	3	2	1							
3													
4	7	8	9	10	11	12							
5													
6	18	17	16	15	14	13							
7													
8	19	20	21	22	23	24							
9													
10	30	29	28	27	26	25							
11													
12	31	32	33	34	35	36							
13													

A. Description of original monument and accessories and/or subsequent restoration:

(A-2) GLO Post set by Lewis Clason April 1840.
 Wits: Beech 10" S 47° W 38 links Beech 22" N 41° W 31 links
 Frank N. Smith P.S. #706 Co. Surveyor in 1941 established Cor. Wits marked: (N 45° E 50' Conc. Mon.) (S 45° W 50' Conc. Mon.)
 Donald E. Marlatt P.S. #18660 fnd. Mon. & wits Mon's in 1985.

B. Description of corner evidence found and/or method applied in restoring or reestablishing corner:

(A-2) Fnd. Conc. Mon. at Cor. by Frank N. Smith 2" below road surface & both Wit. Mon's by Smith in good condition.
 (Placed 3" dia. Aluminum cap marked Montmorency Co. Re-Mon. Cor. on same.)

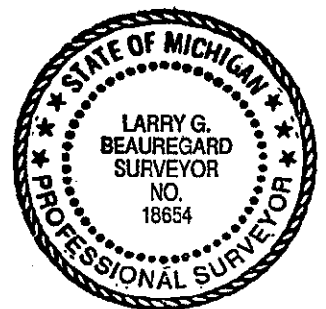

C. Description of monument for corner and accessories established to perpetuate locating the position of the corner:

(A-2) 1/4 Cor. Comm. to Sec. 1 & 6, T30N, R1E & R2E
 4" Conc. Mon. & Re-Mon cap #18654. Accepted as the best available evidence of the position of the original corner, approved by the Peer Group on September 24, 1993.
 N 45° E 50' Conc. Mon. N 40° E 54.05' P. Pole (Placed P.K. nail & P.S. tag in P. Poles.)
 S 45° W 50' Conc. Mon. N 60° W 111.97' P. Pole
 East 33.00' 1/2" bar & cap #18660

Signed by Larry G. Beauregard Date 12-27-93
 Surveyor's Michigan License No. 18654