Montmorency County Remonumentation

Liber 12 Page 62

LAND CORNER RECORDATION CERTIFICATE

Filing Requirement of Act 74, Mich. P.A. 1970

For corners in

Montmorency (County)

	Located In:	Corner Code ##
1. Public Land Survey	T 30N R 2E	(A-12)
	T ____ R ____	
	T ____ R ____	
	T ____ R ____	
2. Property Controlling	S ____ T ____ R ____	
in Section	S ____ T ____ R ____	
3. Miscellaneous	S ____ T ____ R ____	
Property in Sec.	S ____ T ____ R ____	

RECEIVED MONTMORENCY CTY REGISTER OF DEEDS DEC 28 9 06 AM '93 A. PARIGAN-McELROY

Register of Deeds Stamp & File Number

4. Lot No. _____ , Recorded Plat _____
5. Private Claims _____

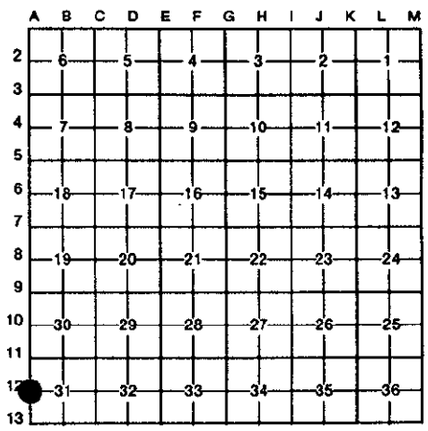

I, Larry G. Beauregard in a field survey on October, 19 93, do hereby certify that under requirements of P.A. 74, Michigan P.A. of 1970, the corner points mentioned in lines 1 and 2 above were in conformance with regulations and rules therefore as required in the current manual of survey instructions of the United States Department of the Interior, Bureau of Land Management or by a decree of a Court of Law and/or that the corner points mentioned in lines 3, 4 and 5 above were in conformance with the rules of the Michigan Board of Land Surveyors or by a Decree of a Court of Law; established, re-established, monumented, re-monumented, recovered, found as expressed below:

NOTE: Not more than 4 corners, all in the same town and range, may be recorded on this certificate.

A. Description of original monument and accessories and/or subsequent restoration:

(A-12) GLO Post set by Lewis Clason April 1840.
Wits: W. Pine 12" S 54° W 48 links Y. Pine 18" N 37° W 53 links

Delmer E. Porter P.S. #15410 (Porters Survey) in 1974 set ½" bar & cap by S.P. method. Filed Act 74 Rec. L. 1, P. 136. Wits marked: (S 88° W 11.06' 6" Maple in clump) (South 19.19' 5" Maple) (N 18° E 56.14' 18" N. Pine).

B. Description of corner evidence found and/or method applied in restoring or reestablishing corner:

(A-12) Fnd. ½" bar & cap #15410.
Re-placed bar & cap with 4" x 36" Conc. Mon. & 3" dia. Aluminum cap marked Montmorency Co. Re-Mon. Cor.

STATE OF MICHIGAN
LARRY G. BEAUREGARD
SURVEYOR
NO. 18654
PROFESSIONAL SURVEYOR

C. Description of monument for corner and accessories established to perpetuate locating the position of the corner:

(A-12) ¼ Cor. Comm. to Sec's 31 & 36, T30N, R1E & T30N, R2E

4" x 36" Conc. Mon. & Re-Mon. cap #18654, accepted as the best available evidence of the reestablishment of the original corner, approved by the Peer Group on September 24, 1993.

S 88° W	11.06'	8" Maple in clump (R) NBT Ex. blaze
South	19.19'	7" Maple (R) NBT Ex. blaze
N 18° E	56.14'	20" N. Pine (R) NBT Ex. blaze
S 55° E	25.38'	6" Maple (N) NBT

(Placed 20 penny spike & P.S. tag #18654) (typ)

Signed by Larry G. Beauregard Date 12-27-93

Surveyor's Michigan License No. 18654

FORM APPROVED BY MICHIGAN STATE BOARD OF LAND SURVEYORS, JAN. 28, 1971
REVISED MAY 14, 1975
REVISED JAN., 1983