


Montmorency County Remonumentation

Liber 12 Page 63

LAND CORNER RECORDATION CERTIFICATE Filing Requirement of Act 74, Mich. P.A. 1970

For corners in

<u>Montmorency</u> (County)	Located In:	Corner Code #
1. Public Land Survey	T <u>30N</u> R <u>2E</u>	<u>(A-13)</u>
	T _____ R _____	_____
	T _____ R _____	_____
	T _____ R _____	_____
2. Property Controlling in Section	S _____ T _____ R _____	_____
	S _____ T _____ R _____	_____
3. Miscellaneous Property in Sec.	S _____ T _____ R _____	_____
	S _____ T _____ R _____	_____
4. Lot No. _____, Recorded Plat _____		
5. Private Claims _____		

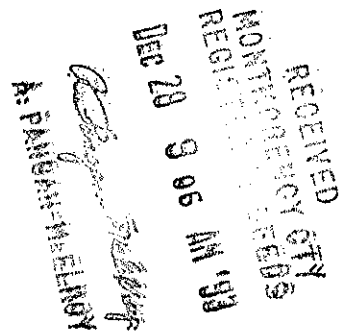

Register of Deeds Stamp & File Number

A	B	C	D	E	F	G	H	I	J	K	L	M
2	6	5	4	3	2	1						
3												
4	7	8	9	10	11	12						
5												
6	18	17	16	15	14	13						
7												
8	19	20	21	22	23	24						
9												
10	30	29	28	27	26	25						
11												
12	31	32	33	34	35	36						
13												

I, Larry G. Beauregard in a field survey on October, 19 93, do hereby certify that under requirements of P.A. 74, Michigan P.A. of 1970, the corner points mentioned in lines 1 and 2 above were in conformance with regulations and rules therefore as required in the current manual of survey instructions of the United States Department of the Interior, Bureau of Land Management or by a decree of a Court of Law and/or that the corner points mentioned in lines 3, 4 and 5 above were in conformance with the rules of the Michigan Board of Land Surveyors or by a Decree of a Court of Law, established, re-established, monumented, re-monumented, recovered, found as expressed below:

NOTE: Not more than 4 corners, all in the same town and range, may be recorded on this certificate.

A. Description of original monument and accessories and/or subsequent restoration:

(A-13) GLO Post set by Lewis Clason April 1840.
 Wits: W. Pine 12" S 61° E 43 links Y. Pine 8" S 62° W 25 links
 Y. Pine 12" N 61° W 8 links Y. Pine 9" N 21° E 7 links
 Frank N. Smith P.S. #706 in 1940 fnd two BT's (Y. Pine stp. 12" N 61° W 8 links) (good face), (B.T. Y. Pine stp. 12" N 21° E 7 links) (good face), Set Conc. Mon. at corner & two Wits Mon's: (N 45° W 50' 4" Conc. Mon.) (S 45° E 50' 4" Conc. Mon.).
 Kenneth J. Ostling P.S. #10068 (DNR Surveyor) in 1966 fnd. Smith Cor. Mon. wits mon's. Ken also set a 1" pipe with 4" Aluminum cap along side Smiths Mon. & marked three wits: (S 49° E 7" R. Oak 23.1') (S 24° W 7" R. Oak 13.1') (North 8" R. Oak 16.2').
 Delmer E. Porter P.S. #15410 (Porters Survey) in 1973 fnd. Smith Mon. for Cor. wits mon's & marked three wits: (S 25° W 13.19' 9" Tw. Oak (old wits), (N 20° E 16.26' 10" Tw. Oak (old wits), (S 60° E 23.70' 9" Oak in clump (old wits). Filed Act 74 Rec. L. 1, P. 50.

B. Description of corner evidence found and/or method applied in restoring or reestablishing corner:

(A-13) Fnd. Conc. Mon. by Smith at Cor. & wits mon's. Also fnd. DNR pipe & cap by Ostling along side of Mon. & wits by Porter & Ostling. Placed 3" dia. Aluminum cap marked Montmorency Co. Re-Mon. Cor. on Mon.

C. Description of monument for corner and accessories established to perpetuate locating the position of the corner:

(A-13) Twp. Cor. Comm. to Sec's 1-6-31 & 36, T29N, R1E & T29N, R2E & T30N, R1E, T30N, R2E
 4" x 36" Conc. Mon. & Re-Mon. cap #18654, accepted as a perpetuation of the original government corner, approved by the Peer Group on September 24, 1993.
 N 45° W 49.8' Conc. Mon. (R) Wits. S 45° E 49.8' Conc. Mon. (R) Wits.
 S 25° E 13.19' Tw. 12" Oaks (R) NBT. N 20° E 16.26' Tw. 14" Oaks (R) NBT.
 (Placed 20 penny spike & P.S. tag #18654) (typ)

Signed by Larry G. Beauregard
 Surveyor's Michigan License No. 18654

Date 12-27-93

