

FEB 08 2000

Montmorency County Remonumentation

Liber 00012 Page 0364

SECTION

LAND CORNER RECORDATION CERTIFICATE  
Filing Requirement of Act 74, Mich. P.A. 1970

For corners in

MONTMORENCY  
(County)

Located in:

Corner Code #

BRILEY TWP.  
1. Public Land Survey

T 30N R 2E G-1

T \_\_\_\_\_ R \_\_\_\_\_

T \_\_\_\_\_ R \_\_\_\_\_

T \_\_\_\_\_ R \_\_\_\_\_

2. Property Controlling  
In Section

S \_\_\_\_\_ T \_\_\_\_\_ R \_\_\_\_\_

S \_\_\_\_\_ T \_\_\_\_\_ R \_\_\_\_\_

3. Miscellaneous  
Property in Sec.

S \_\_\_\_\_ T \_\_\_\_\_ R \_\_\_\_\_

S \_\_\_\_\_ T \_\_\_\_\_ R \_\_\_\_\_

STATE OF MICHIGAN  
MONTMORENCY COUNTY  
Recorded & Filed

11-12-1999 09:27:19

TERESA WALKER  
REGISTER OF DEEDS

Register of Deeds Stamp & File Number

4. Lot No. \_\_\_\_\_, Recorded Plat \_\_\_\_\_  
5. Private Claims \_\_\_\_\_

I, DONALD E MARLATT, in a field survey on JULY, 1999 do hereby state that under requirements of P.A. 74, Michigan P.A. of 1970, the corner points mentioned in lines 1 and 2 above were in conformance with regulations and rules therefore as required in the current manual of survey instructions of the United States Department of the Interior, Bureau of Land Management or by a decree of a Court of Law and /or that the corner points mentioned in lines 3, 4 and 5 above were in conformance with the rules of the Michigan Board of Land Surveyors or by a Decree of a Court of Law; established, re-established, monumented, recovered, found as expressed below:

NOTE: Not more than 2 corners, all in the same town and range, may be recorded on this certificate.

A	B	C	D	E	F	G	H	I	J	K	L	M
1												
2	6		5		4		3		2		1	
3												
4	7		8		9		10		11		12	
5												
6	18		17		16		15		14		13	
7												
8	19		20		21		22		23		24	
9												
10	30		29		28		27		26		25	
11												
12	31		32		33		34		35		36	
13												

A. Description of original monument and accessories and/or subsequent restoration:

G-1 NORTH CORNER COMMON TO SEC.'S 3 & 4.  
GLO CORNER SET BY LEWIS CLASON IN APRIL 1840. HEM. 12" S69°W 47 L.- HEM. 12" S19°E 42 L.  
D.E. MARLATT PS#18660 ACT 132 DATED 5-14-79. SET 1/2"ROD S.P. BETW. F-1 & I-1 USING THE COR.S ON THE SOUTH OF T31N, R2E FOR LINE.N50°W 86.5' 10"APPLE, N48°E S.W. COR. OF HSE 122.15', SOUTH 33' 1/2"ROD. (NOT RECORDED)  
D.E. MARLATT ACT 132 DATED 5-19-79(SAME AS ABOVE) (NOT RECORDED)  
L. BEAUREGARD PS#18654 NOTES. FOUND 1/2"ROD & CAP. SOUTH 26.5' FE. POST, N45°W 48.75' FE. POST, N65°E P.POLE 75.74'. DATE: 7-14-1997.

B. Description of corner evidence found and/or method applied in restoring or reestablishing corner:

G-1 NORTH CORNER COMMON TO SEC.S 3 & 4.  
FOUND 1/2"ROD & CAP#18660  
SOUTH 33' 1/2"ROD R.  
N68°E P.POLE 75.78' (BEAUREGARD NOTES)  
N40°W COR. FE. POST 48.8'(BEAUREGARD NOTES)  
N48°E S.W. COR. OF HSE 122.15' R.


APPROVED BY  
PEER GROUP

JUL 20 99

*J.L.B.*

C. Description of monument for corner and accessories established to perpetuate locating the position of the corner:

G-1 NORTH CORNER COMMON TO SEC.S 3 & 4.  
SET CONC. MONUMENT WITH REMON. CAP.  
N40°W FE. POST 48.68'  
N68°E P.POLE 75.77'  
S73°W 24"WALNUT 55.05'  
S50°W 22"WALNUT 29.08'  
WITNESSES MARKED WITH 40 PENNY SPIKES & PS TAG #18660.  
APPROVED BY PEER GROUP JULY 20, 1999 AS A CAREFUL AND FAITHFUL ESTABLISHMENT OF THE POSITION OF THE CORNER.

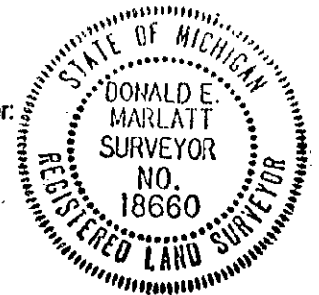

Signed by Donald E Marlatt  
Surveyor's Michigan License No. 18660

Date 11-8-99