

FEB 08 2000

SECTION

LAND CORNER RECORDATION CERTIFICATE
Filing Requirement of Act 74, Mich. P.A. 1970

For corners in

MONTMORENCY (County)	Located In:	Corner Code #
BRILEY TWP.	T 30N R 2E	H -1
1. Public Land Survey	T ___ R ___	_____
	T ___ R ___	_____
	T ___ R ___	_____
2. Property Controlling In Section	S ___ T ___ R ___	_____
	S ___ T ___ R ___	_____
3. Miscellaneous Property in Sec.	S ___ T ___ R ___	_____
	S ___ T ___ R ___	_____

STATE OF MICHIGAN
MONTMORENCY COUNTY
Recorded & Filed

11-12-1999 09:27:02

TERESA WALKER
REGISTER OF DEEDS

Register of Deeds Stamp & File Number

4. Lot No. _____, Recorded Plat _____
5. Private Claims _____

I, DONALD E MARLATT, in a field survey on JULY, 1999 do hereby state that under requirements of P.A. 74, Michigan P.A. of 1970, the corner points mentioned in lines 1 and 2 above were in conformance with regulations and rules therefore as required in the current manual of survey instructions of the United States Department of the Interior, Bureau of Land Management or by a decree of a Court of Law and for that the corner points mentioned in lines 3, 4 and 5 above were in conformance with the rules of the Michigan Board of Land Surveyors or by a Decree of a Court of Law; established, re-established, monumented, recovered, found as expressed below:

NOTE: Not more than 2 corners, all in the same town and range, may be recorded on this certificate.

	A	B	C	D	E	F	G	H	I	J	K	L	M
1													
2		6		5		4		3		2		1	
3													
4		7		8		9		10		11		12	
5													
6		18		17		16		15		14		13	
7													
8		19		20		21		22		23		24	
9													
10		30		29		28		27		26		25	
11													
12		31		32		33		34		35		36	
13													


A. Description of original monument and accessories and/or subsequent restoration:
H-1 N. 1/4 OF SEC. 3
NO CORNER SET ON GLO SURVEY.
D.E. MARLATT PS#18660 ACT 132 DATED 7-7-82. FD. 1/2 ROD PREVIOUSLY SET S.P. BETW. F-1 & I-1 USING COR.S ON SOUTH LINE TO T31N, R2E FOR LINE. S35°W 6"CEDAR 58.45', S33°E 8"CEDAR 60.3
D.E. MARLATT ACT 132 DATED 8-1-89. FD. 1/2"ROD. S35°W 7"CEDAR 58.45', S33°E 9"CEDAR 60.39', SOUTH 33' 1/2" ROD. (NOT RECORDED)
L. BEAUREGARD NOTES: FOUND 1/2"ROD(MARLATT) SOUTH 33' 1/2"B. & C. DEM, S35°W 58.45' 6"CEDAR, S35°E 60.36' 6"CEDAR, N30°W 41.64' P.POLE. (DATE 7-14-97)

B. Description of corner evidence found and/or method applied in restoring or reestablishing corner:
H - 1 NORTH 1/4 COR. OF SEC. 3
FD. 1/2"ROD.
SOUTH 33' 1/2"ROD & CAP#18660
S35°W 58.45' 7"CEDAR R.
S33°E 60.39' 9"CEDAR R.
N30°W 41.64' P.POLE (BEAUREGARD'S NOTES)

APPROVED BY
PEER GROUP

JUL 20 99
L. G. B.

C. Description of monument for corner and accessories established to perpetuate locating the position of the corner:
H - 1 NORTH 1/4 COR. OF SEC. 3
SET CONC. MONUMENT AND REMON. CAP.
S40°W 9"CEDAR 58.45'
S29°E 8"CEDAR 60.36'
S54°E 12" TAMRACK 62.56'
N28°W P.POLE 41.60'

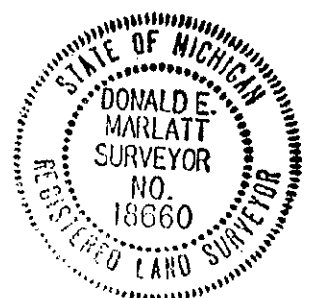

WITNESSES MARKED WITH 40 PENNY SPIKES AND PS TAG#18660.
APPROVED BY PEER GROUP JULY 20, 1999 AS CAREFUL AND FAITHFUL ESTABLISHMENT OF THE POSITION OF THE CORNER.

Signed by Donald E Marlatt

Date 11-8-99

Surveyor's Michigan License No. 18660