


SURVEY & REMONUMENTATION

NOV 23 1999

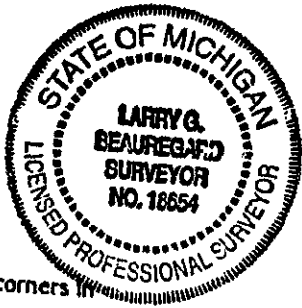

SECTION
MONTMORENCY COUNTY REMONUMENTATION

Liber 00012 Page 0348

LAND CORNER RECORDATION CERTIFICATE
Filing Requirement of Act 74, Mich. P.A. 1970

For corners in

<u>Montmorency</u> (County)	Located in: <u>Briley</u> (Township)	Corner Code # <u>H-11</u>
1. Public Land Survey	<u>T 30N R 2E</u>	
	T <u> </u> R <u> </u>	
	T <u> </u> R <u> </u>	
	T <u> </u> R <u> </u>	
2. Property Controlling In Section	S <u> </u> T <u> </u> R <u> </u>	
	S <u> </u> T <u> </u> R <u> </u>	
3. Miscellaneous Property in Sec.	S <u> </u> T <u> </u> R <u> </u>	
	S <u> </u> T <u> </u> R <u> </u>	
4. Lot No. <u> </u> , Recorded Plat <u> </u>		
5. Private Claims <u> </u>		

STATE OF MICHIGAN
MONTMORENCY COUNTY
Recorded & Filed


08-10-1999 14:44:07

TERESA WALKER
REGISTER OF DEEDS

Register of Deeds Stamp & File
Number

I, Larry G. Beauregard, in a field survey on April, 1999 do hereby certify that under requirements of P.A. 74, Michigan P.A. of 1970, the corner points mentioned in lines 1 and 2 above were in conformance with regulations and rules therefore as required in the current manual of survey instructions of the United States Department of the Interior, Bureau of Land Management or by a decree of a Court of Law and /or that the corner points mentioned in lines 3, 4 and 5 above were in conformance with the rules of the Michigan Board of Land Surveyors or by a Decree of a Court of Law; established, re-established, monumented, re-monumented, recovered, found as expressed below:

NOTE: Not more than 2 corners, all in the same town and range, may be recorded on this certificate.

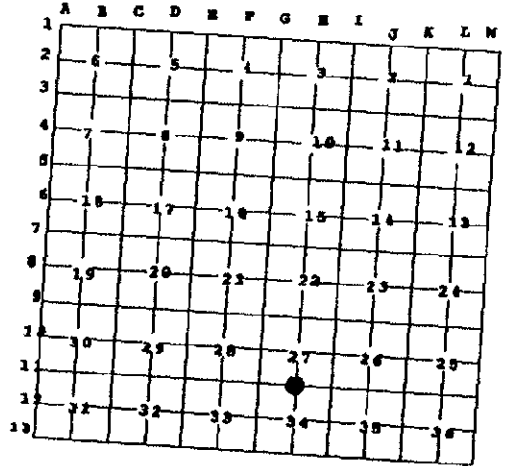

A. Description of original monument and accessories and/or subsequent restoration:
H-11 - 1/4 Cor. 27 & 34, T30N, R2E

1840 - Lewis Clason, D.S. Set Cr. Sec. Post. Wit's mkd.
(Y. Pine 24° N53W 46 lks) (Y. Pine 14° N47E 48 lks).

1976 - Donald E. Marlatt, RLS #18660. Set 1/2" bar & cap by single proportionate method. Wit's mkd. (N20°E 8" Oak 16.0') (S15°W 9" Oak 9.55').

1988 - Delmer E. Porter, RLS #15410. Fnd. 1/2" bar & RLS cap by Marlatt. Wit's mkd. (N35°W 16.44' 12" Oak) (N45°W 10" Oak 16.0') (S15°W 9" Oak 9.55')

B. Description of corner evidence found and/or method applied in restoring or reestablishing corner:

April, 1999 - Fnd. 1/2" bar by Marlatt, no cap, and Wit's by Porter. No evidence of original corner or wit's. Old hunting wire & barb wire fence running West 39' North of 1/2" bar found. Replaced 1/2" bar with a 3 1/4" Aluminum Re-mon. cap on a 4" dia. X 36" conc. mon.

C. Description of monument for corner and accessories established to perpetuate locating the position of the corner:
H-11 - 1/4 Cor. 27 & 34, T30N, R2E

3 1/4" Aluminum Re-mon. cap on 4" dia. X 36" concrete monument.

Accepted as the best available evidence of the re-establishment of the original corner.

Approved by the Peer Group on July 20, 1999.

- N24°E 12.85' 8" Oak (R) (Ex. Spike & P.S. Tag #18660)
- N38°W 16.42' 13" Oak (R) (" " " " " " " ")
- S24°W 9.78' 9" Oak (R) (" " " " " " " ")
- S20°E 16.90' 12" Oak (R) (Existing spike, no tag)
- S50°E 30.40' 10" Oak (R) (Placed 60d Spike & Tag #18654)

APPROVED BY
PEER GROUP

JUL 20 99

Signed by Larry G. Beauregard
Surveyor's Michigan License No. 18654

Date, August 5, 1999

FORM APPROVED BY MICHIGAN STATE BOARD OF PROFESSIONAL SURVEYORS, JAN. 28, 1971

REVISED MAY 14, 1975
REVISED JAN., 1983
REVISED OCT., 1996