

FEB 08 2000

SECTION

Montmorency County Remonumentation

Liber 00012 Page 0368

LAND CORNER RECORDATION CERTIFICATE  
Filing Requirement of Act 74, Mich. P.A. 1970

For corners in

MONTMORENCY

(County)

BRILEY TOWNSHIP

1. Public Land Survey

2. Property Controlling  
in Section  
3. Miscellaneous  
Property in Sec.

Located in:

Corner Code #

T	30N	R	2E	I - 2
T		R		
T		R		
T		R		
S	T	R		
S	T	R		
S	T	R		
S	T	R		

STATE OF MICHIGAN  
MONTMORENCY COUNTY  
Recorded & Filed

11-12-1999 09:26:46

TERESA WALKER  
REGISTER OF DEEDS

Register of Deeds Stamp & File Number

4. Lot No. \_\_\_\_\_, Recorded Plat \_\_\_\_\_

5. Private Claims \_\_\_\_\_

I, DONALD E MARLATT, in a field survey on JULY, 19 99 do hereby state that under requirements of P.A. 74, Michigan P.A. of 1970, the corner points mentioned in lines 1 and 2 above were in conformance with regulations and rules therefore as required in the current manual of survey instructions of the United States Department of the Interior, Bureau of Land Management or by a decree of a Court of Law and/or that the corner points mentioned in lines 3, 4 and 5 above were in conformance with the rules of the Michigan Board of Land Surveyors or by a Decree of a Court of Law; established, re-established, monumented, recovered, found as expressed below:

NOTE: Not more than 2 corners, all in the same town and range, may be recorded on this certificate.

1	A	B	C	D	E	F	G	H	I	J	K	L	M
2		6		5		4		3		2		1	
3													
4		7		8		9		10		11		12	
5													
6		18		17		16		15		14		13	
7													
8		19		20		21		22		23		24	
9													
10		30		29		28		27		26		25	
11													
12		31		32		33		34		35		36	
13													

A. Description of original monument and accessories and/or subsequent restoration:  
I - 2 1/4 COR. COMMON TO SEC.S 2 & 3.  
GLO CORNER SET-LEWIS CLASON APRIL 1840.  
FIR 8" S12°E 10 L., FIR 10" N48W 20 L.  
D.E. MARLATT PS#18660 ACT 132 DATED 7-7-82 . (NOT RECORDED)  
FOUND 3/4"PIPE & 2 SQ. CEDAR STAKES. NO WITNESSES.

B. Description of corner evidence found and/or method applied in restoring or reestablishing corner:  
I - 2 1/4 CORNER COMMON TO SEC.S 2 & 3.  
FOUND 3/4"PIPE & SQ. CEDAR(ALSO OLDER SQ. CEDAR LYING DOWN)  
WEST 6"TAMRACK 7.7'  
S32°E 10"TAMRACK 27.3'  
N50°E 10"TAMRACK 28.6'


APPROVED BY  
PEER GROUP

JUL 20 99

L. G. B.

C. Description of monument for corner and accessories established to perpetuate locating the position of the corner:  
I - 2 1/4 CORNER COMMON TO SEC.S 2 & 3  
SET CONC. MONUMENT WITH REMON. CAP.  
S30°E 10"TAMRACK 27.56'  
N50°E 9"TAMRACK 28.65'  
N 1°W 15"W. PINE 25.22'  
N80°W 8"TAMRACK 7.76'

WITNESSES MARKED WITH 40 PENNY SPIKES AND PS TAGS#18660.  
APPROVED BY PEER GROUP JULY 20, 1999 as THE BEST AVAILABLE EVIDENCE OF THE POSITION  
OF THE ORIGINAL CORNER.

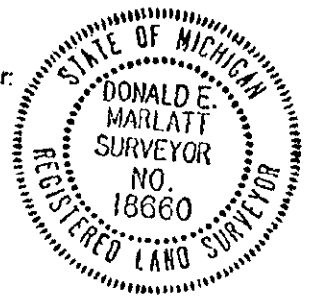

Signed by Donald E Marlatt

Surveyor's Michigan License No. 18660

Date 11-8-99