

NOV 23 1999

Liber 00012 Page 0358



SECTION MONTMORENCY COUNTY REMONUMENTATION


LAND CORNER RECORDATION CERTIFICATE Filing Requirement of Act 74, Mich. P.A. 1970

Form with fields for County (Montmorency), Township (Briley), Corner Code # (1-9), and numbered sections 1-5 for survey details.

STATE OF MICHIGAN MONTMORENCY COUNTY Recorded & Filed 08-10-1999 14:46:23 TERESA WALKER REGISTER OF DEEDS Register of Deeds Stamp & File Number

I, Larry G. Beauregard, in a field survey on April, 19 99 do hereby certify that under requirements of P.A. 74, Michigan P.A. of 1970, the corner points mentioned in lines 1 and 2 above were in conformance with regulations and rules therefore as required in the current manual of survey instructions of the United States Department of the Interior, Bureau of Land Management or by a decree of a Court of Law and /or that the corner points mentioned in lines 3, 4 and 5 above were in conformance with the rules of the Michigan Board of Land Surveyors or by a Decree of a Court of Law; established, re-established, monumented, re-monumented, recovered, found as expressed below:

NOTE: Not more than 2 corners, all in the same town and range, may be recorded on this certificate.

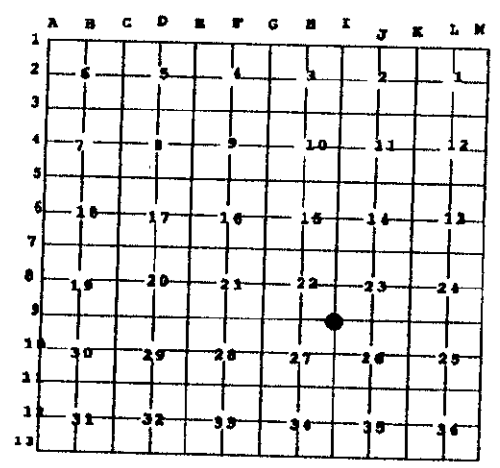

A. Description of original monument and accessories and/or subsequent restoration: 1-9 - Section Corner common to 22, 23, 26 & 27, T30N, R2E

1840 - Lewis Clason, D.S. Set Cr. Sec. Post. Wit's mkd. (W. Pine 12° N34W 9 lks) (Y. Pine 28° S17E 46 lks).

No date - Montmorency Co. Rd. Comm. Records. Fnd. Old stk. With spike in top & wire around stk. Wit's (O.B.T. Y. Pine stp. S12E 29.6) (N.B.T. Y. Pine stp. N38E 76.5) (N.B.T. 8° Oak S7W 40.7').

1972 - Delmer E. Porter, RLS #15410. Set 1/2" rod & cap in intersection of Roads & 33' South & West of Fe. Cor. in line w/CL of the T. road to the North. Filed LCRC, Rec. L. 1, P. 5. Wit's mkd. (P. Pole S50°W 67.05) (10" Oak N40°E 59.10') (8" Poplar S20°E 54.74') (4" conc. Mon. 40' N. & 33' E.). Filed Act #132, Rec. L. 1, P. 178. Same Wit's as above.

1974 - Larry G. Beauregard, RLS #18654. Fnd. 1/2" bar, cap & wit's by Porter, mentioned above. No new Wit's mkd. Prepared Act #132. Not recorded.

1977 - Kenneth J. Ostling, RLS #10068, DNR Surveyor. Fnd. 1/2" iron bar by Porter in a Retracement Survey of Sec. 27. No new Wit's Mkd.

B. Description of corner evidence found and/or method applied in restoring or reestablishing corner: April, 1999 - Fnd. 2" sq. stk. with spike in top in the center line of Co. Rd. #489 E. & W. and the center line of Ryan Rd. North. This stk. is 1.05 SW of 1/2" bar & cap by Porter. Replaced stk. with a 3 1/4" Aluminum Re-mon. cap on a 4" dia. X 36" conc. mon. 6" below road surface.

C. Description of monument for corner and accessories established to perpetuate locating the position of the corner: 1-9 - Section Corner common to 22, 23, 26 & 27, T30N, R2E

3 1/4" Aluminum Re-mon. cap on 4" dia. X 36" concrete monument. Accepted as a perpetuation of the original government corner. Approved by the Peer Group on July 20, 1999.

- List of bearings and distances: N38°E 76.50' 24" Pine stump (R) (Face of existing blaze), N50°E 60.16' 18" R. Oak (R) (Placed 60d spike & P.S. Tag #18654), S12°E 67.16' 13" Cherry, S64°W 121.14' 9" W. Oak, N48°E 57.78' (4" x 36" Conc. Mon. & P.S. Cap #15410), N48°E 1.05' (1/2" bar & P.S. Cap #15410) (Reference point)

APPROVED BY PEER GROUP

JUL 20 99 L.G.B.

Signed by Larry G. Beauregard

Date, August 5, 1999

Surveyor's Michigan License No. 18654