

FEB 08 2000

Montmorency County Remonumentation

SECTION

LAND CORNER RECORDATION CERTIFICATE
Filing Requirement of Act 74, Mich. P.A. 1970

For corners in

MONTMORENCY COUNTY (County)	Located in:	Corner Code #
BRILEY TWP.		
1. Public Land Survey	T <u>30</u> R <u>2</u> E	J-3
	T <u> </u> R <u> </u>	_____
	T <u> </u> R <u> </u>	_____
	T <u> </u> R <u> </u>	_____
2. Property Controlling in Section	S <u> </u> T <u> </u> R <u> </u>	_____
	S <u> </u> T <u> </u> R <u> </u>	_____
3. Miscellaneous Property in Sec.	S <u> </u> T <u> </u> R <u> </u>	_____
	S <u> </u> T <u> </u> R <u> </u>	_____

STATE OF MICHIGAN
MONTMORENCY COUNTY
Recorded & Filed

11-12-1999 09:26:04

TERESA WALKER
REGISTER OF DEEDS

Register of Deeds Stamp & File Number

4. Lot No. _____, Recorded Plat _____
5. Private Claims _____

I, DONALD E MARLATT, in a field survey on AUG. 20, 1999 do hereby state that under requirements of P.A. 74, Michigan P.A. of 1970, the corner points mentioned in lines 1 and 2 above were in conformance with regulations and rules therefore as required in the current manual of survey instructions of the United States Department of the Interior, Bureau of Land Management or by a decree of a Court of Law and for that the corner points mentioned in lines 3, 4 and 5 above were in conformance with the rules of the Michigan Board of Land Surveyors or by a Decree of a Court of Law; established, re-established, monumented, recovered, found as expressed below:

NOTE: Not more than 2 corners, all in the same town and range, may be recorded on this certificate.


A	B	C	D	E	F	G	H	I	J	K	L	M
1												
2	6		5		4		3		2		1	
3									●			
4	7		8		9		10		11		12	
5												
6	18		17		16		15		14		13	
7												
8	19		20		21		22		23		24	
9												
10	30		29		28		27		26		25	
11												
12	31		32		33		34		35		36	
13												

- A. Description of original monument and accessories and/or subsequent restoration:
 J - 3 1/4 CORNER COMMON TO SEC.S 2 & 11.
 GLO CORNER SET BY LEWIS CLASON IN APRIL 1840. W. BIRCH 7" N52°W 11 L., W.PINE 6" S40°E 13 L.
 G.F. DELAMATER PS#693 NOTES. NO DATE. FD. IRON IN RD. C/L. CONC. MON. N36°W 49.7', CONC. MON. S36°E 49.9'.
 F. SMITH PS#754 NOTES. FOUND IRON IN COR.(WIT. SAME AS ABOVE).(DELAMATER) NO DATE.
 COUNTY RD COMM. NOTES 1941. MONUMENT IN COR. (WIT. SAME AS ABOVE).
 G. SLATTERY MSHD 1967. FD. CONC. MON. FLUSH WITH SURFACE IN C/L OF ROAD. RAIL FENCE WEST. S78°W 51.54' 14"TW. N. PINE, S32°E 49.85' CONC. MON., N62°E 52.65' S.W. COR. OF HSE.
 N.C. CALDWELL PS #12018 ACT 132, 10-8-71. L. 1, P. 196. NO WITNESS OR DESCRIPTION.
 D.E. PORTER PS#15410 ACT 132 DATED 3-22-76. L. 2, P. 148. FD. CONC. MON. N36°W 49.67' 1/2"ROD & CAP#12018, S33°E 73.99' 8"W.PINE, S73°W 51.48' 12"N.PINE.
 RON BISCHER PS#22428 ACT 74 DATED 4-10-76. L. 1, P. 160. FD CONC. MON. WIT SAME AS ABOVE.
 D.E. MARLATT PS#18660 ACT 132 DATED 8-20-76. FD. MON. S78°W 51.54' 14"TW. N.PINE, S32°E 49.85' CONC. MON., N62°E 52.65' S.W. COR. OF HSE FDN. L. 2, P. 227.
 D.E. MARLATT ACT 132 DATED 3-15-87.FD. CONC. MON. S33°E 74' 10"W.PINE, S73°W 51.48' 14"W.PINE
 L. BEAUREGARD PS#18654 ACT 132 DATED 11-25-98. L.10005, P. 62. FD. FD. BAR & CAP IN MON. BOX. NO WITNESS.
- B. Description of cor. evidence found and/or method applied in restoring or reestablishing corner
 J - 3 1/4 COR. COMMON TO SEC.S 2 & 11.
 FOUND 1"PIPE & CAP IN MON. BOX.
 S33°E 73.99' 12"W.PINE, N62°E 52.65' S.W. COR. OF HSE, S73°W 51.48' 20"TW. N.PINE (ALL REC.WIT. S73°W 51.48')
- C. Description of monument for corner and accessories established to perpetuate locating the position of the corner.
 J - 3 1/4 CORNER COMMON TO SEC.S 2 & 11.
 SET 1/2"ROD & REMON. CAP IN 1"PIPE IN MONUMENT BOX.
 S77°W TW. 17"R.PINE 50.95' N62°E 52.65' S.W. COR. HSE.
 N39°W 12"RED PINE 64.24'
 S30°E 12"W.PINE 73.43'
 N84°W 13"W.PINE 30.85'

APPROVED BY
PEER GROUP

JUL 20 99

L.H.B.

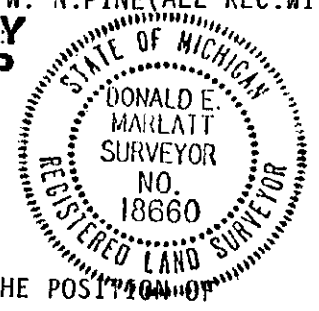

WITNESSES MARKED WITH 40 PENNY SPIKES AND PS TAG#18660.
APPROVED BY PEER GROUP JULY 20, 1999 AS THE BEST AVAILABLE EVIDENCE OF THE POSITION OF THE ORIGINAL CORNER.

Signed by Donald E Marlatt
Surveyor's Michigan License No. 18660

Date 11-8-99