

**SURVEY &
REMONUMENTATION**

NOV 23 1999

Liber **00012** Page **0352**



SECTION

MONTMORENCY COUNTY REMONUMENTATION

LAND CORNER RECORDATION CERTIFICATE
Filing Requirement of Act 74, Mich. P.A. 1970

For corners in

<u>Montmorency</u> (County)	Located in: <u>Briley</u> (Township)	Corner Code #
1. Public Land Survey	<u>T 30N R 2E</u>	<u>J-11</u>
—	T ___ R ___	_____
—	T ___ R ___	_____
—	T ___ R ___	_____
2. Property Controlling in Section	S ___ T ___ R ___	_____
—	S ___ T ___ R ___	_____
3. Miscellaneous Property in Sec.	S ___ T ___ R ___	_____
—	S ___ T ___ R ___	_____
4. Lot No. _____, Recorded Plat _____		
5. Private Claims _____		

STATE OF MICHIGAN
MONTMORENCY COUNTY
Recorded & Filed

08-10-1999 14:45:07

TERESA WALKER
REGISTER OF DEEDS

Register of Deeds Stamp & File
Number

I, Larry G. Beauregard, in a field survey on April, 1999 do hereby certify that under requirements of P.A. 74, Michigan P.A. of 1970, the corner points mentioned in lines 1 and 2 above were in conformance with regulations and rules therefore as required in the current manual of survey instructions of the United States Department of the Interior, Bureau of Land Management or by a decree of a Court of Law and /or that the corner points mentioned in lines 3, 4 and 5 above were in conformance with the rules of the Michigan Board of Land Surveyors or by a Decree of a Court of Law; established, re-established, monumented, re-monumented, recovered, found as expressed below:

NOTE: Not more than 2 corners, all in the same town and range, may be recorded on this certificate.

A. Description of original monument and accessories and/or subsequent restoration:
J-11 - 1/4 Cor. 26 & 35, T30N, R2E

1840 - Lewis Clason, D.S. Set Q r. Sec. Post. Wit's mkd.
(W. Pine 6" S53E 30 lks) (DO 12" N17W 21 lks)

1973 - Delmer E. Porter, RLS #15410. Set 1/2" bar, cap & 3" x 3" sq. Cedar stake by single proportionate measurement between I-11 & K-11. Filed Act #132, Rec. L. 1, P. 294 & filed LCRC, Rec. L. 1, P. 55. Wit's mkd. (N68°-46'W 122.52' 18" Norway Pine) (N07°-36'W 105.75' 8" Norway Pine) (N78°-24'E 49.16' 4" Norway Pine)

1990's - James L. Schwndt, PS #26466. Fnd. Iron. Wit's Mkd. (N30W 12" Cherry 20.64) (S50W 12" R. Pine 4.65) (S35E 10" R. Pine 6.66) (S65W 10" R. Pine 17.42)

B. Description of corner evidence found and/or method applied in restoring or reestablishing corner:

April, 1999 - Fnd. 1/2" bar, cap, Cedar stake & Wit's by Porter. Replaced 1/2" bar & cap with a 3 1/2" Aluminum Re-mon. cap on a 4" dia. X 36" conc. mon.


C. Description of monument for corner and accessories established to perpetuate locating the position of the corner:
J-11 - 1/4 Cor. Sections 26 & 35, T30N, R2E

3 1/2" Aluminum Re-mon. cap on 4" dia. X 36" concrete monument.

Accepted as the best available evidence of the re-establishment to perpetuate locating the position of the corner.

Approved by the Peer Group on July 20, 1999.

N56°W 122.52' (R & M) 26" Norway (R) (Placed 60d Spike & P.S. Tag #18654)
North 105.75' (R & M) 16" Norway (R) (" " " " " ")
N88°E 49.16' (R & M) 14" Norway (R) (" " " " " ")
S04°W 48.61' 11" W. Pine (" " " " " ")

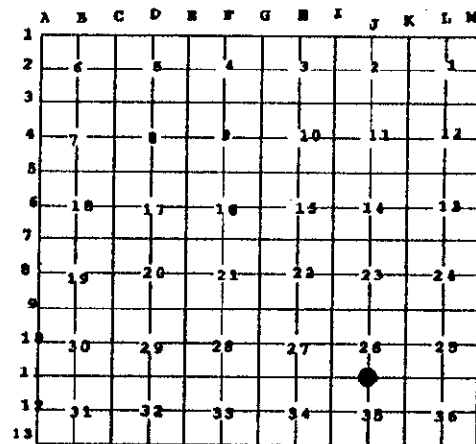

**APPROVED BY
PEER GROUP**

JUL 20 99

Signed by Larry G. Beauregard

Date, August 5, 1999

Surveyor's Michigan License No. 18654