

FEB 08 2000

SECTION

LAND CORNER RECORDATION CERTIFICATE
Filing Requirement of Act 74, Mich. P.A. 1970

For corners in

<u>MONTMORENCY</u> (County)	Located in:	Corner Code #
<u>BRILEY TWP.</u>	T 30N R 2E	K - 2
1. Public Land Survey	T ___ R ___	_____
	T ___ R ___	_____
	T ___ R ___	_____
2. Property Controlling in Section	S ___ T ___ R ___	_____
	S ___ T ___ R ___	_____
3. Miscellaneous Property in Sec.	S ___ T ___ R ___	_____
	S ___ T ___ R ___	_____

STATE OF MICHIGAN
MONTMORENCY COUNTY
Recorded & Filed

11-12-1999 09:21:28

TERESA WALKER
REGISTER OF DEEDS

Register of Deeds Stamp & File Number

4. Lot No. _____, Recorded Plat _____
5. Private Claims _____

I, DONALD E MARLATT, in a field survey on JULY, 19 99 do hereby state that under requirements of P.A. 74, Michigan P.A. of 1970, the corner points mentioned in lines 1 and 2 above were in conformance with regulations and rules therefore as required in the current manual of survey instructions of the United States Department of the Interior, Bureau of Land Management or by a decree of a Court of Law and /or that the corner points mentioned in lines 3, 4 and 5 above were in conformance with the rules of the Michigan Board of Land Surveyors or by a Decree of a Court of Law; established, re-established, monumented, recovered, found as expressed below:

NOTE: Not more than 2 corners, all in the same town and range, may be recorded on this certificate.

A	B	C	D	E	F	G	H	I	J	K	L	M
1												
2	6		5		4		3		2	●	1	
3												
4	7		8		9		10		11		12	
5												
6	10		17		16		15		14		13	
7												
8	19		20		21		22		23		24	
9												
10	30		29		28		27		26		25	
11												
12	31		32		33		34		35		36	
13												

- A. Description of original monument and accessories and/or subsequent restoration:
 K-2 1/4 COR. COMMON TO SEC.S 1 & 2.
 GLO CORNER SET BY LEWIS CLASON IN APRIL 1840. Y.PINE 6" N15°W 7L, Y.PINE 5" S77°E 13 L.
 F. SMITH PS#754 NOTES JUNE 14, 1947. FD BOTH GOV'T B'S & POST 4X4"OAK STK.
 OAK 14" S86°W 3.4', N.PINE STUB 12" N 2°30'E 34.4', TW OAK 9" N73°30'E 28'.
 D.E.PORTER PS#15410 ACT 132 DATED JUNE 21, 1973. L.1, P.342. NO DESCRIPTION OR WITNESS.
 D.E.PORTER ACT 74 DATED 3-6-75. L. 1, P. 141. FD. VERY OLD 4 X 4"STAKE & ORIGINAL BT STUMP.
 SET 1/2"ROD & CAP. N 2°E 34.66' OBT STUMP, S80°E 19.67' 15"OAK, S80°W 2.76' 18"OAK.
 D.E. PORTER ACT 132 DATED 2-27-75. L.2, P. 70.(SAME AS ABOVE). ALSO SET NEW 4X4"OAK STAKE.
 D.E MARLATT ACT 132 DATED 6-6-87. FD. 1/2"ROD & CAP. N 2°E 34.66' PINE STP NBT,
 S80°E 19.67' 16"OAK, S80°W 2.76' 19"OAK. NOT RECORDED.
- B. Description of cor. evidence found and/or method applied in restoring or reestablishing corner
 K - 2 1/4 CORNER COMMON TO SEC.S 1 & 2.
 FOUND 1/2"ROD & CAP.
 N 2°E 34.66' PINE STP NBT R.
 S80°E 19.67' 16"OAK R.
 S80°W 2.76' 19"OAK(LYING DOWN) R.


APPROVED BY
PEER GROUP

JUL 20 99

R.H.B.

- C. Description of monument for corner and accessories established to perpetuate locating the position of the corner
 K - 2 1/4 COR. COMMON TO SEC.S 1 & 2.
 SET CONC. MONUMENT & REMON. CAP
 S20°W 8"OAK 16.06'
 N 8°E 12"PINE STP. NBT 34.72'
 N79°E 15"OAK 28.61'
 S53°E 12"OAK 30.08'

WITNESSES MARKED WITH 40 PENNY SPIKES & PS TAG#18660.
APPROVED BY PEER GROUP JULY 20, 1999 AS A PERPETUATION OF THE ORIGINAL GOVERNMENT CORNER.

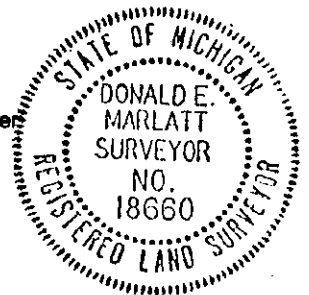

Signed by Donald E Marlatt
Surveyor's Michigan License No. 18660

Date 11-8-99