

**SURVEY &
REMONUMENTATION**

Montmorency County Remonumentation

APR 24 1995

**LAND CORNER RECORDATION CERTIFICATE
Filing Requirement of Act 74, Mich. P.A. 1970**

For corner **COMMISSION**

STATE OF MICHIGAN
MONTMORENCY COUNTY
Recorded & Filed

11-10-1994 14:13:25

A. PANGAN-MCELROY
REGISTER OF DEEDS

Register of Deeds Stamp & File Number

<u>Montmorency</u> (County)	Located In: Briley Township	Corner Code # L-13
1. Public Land Survey	T <u>30</u> NR <u>2</u> E	<u>L-13</u>
	T _____ R _____	
	T _____ R _____	
	T _____ R _____	
2. Property Controlling in Section	S _____ T _____ R _____	
	S _____ T _____ R _____	
3. Miscellaneous Property in Sec.	S _____ T _____ R _____	
	S _____ T _____ R _____	
4. Lot No. _____	Recorded Plat _____	
5. Private Claims _____		

**APPROVED BY
PEER GROUP**

MAY 13 94

J.B.

I, Don Marlatt, in a field survey on November 8, 19 94, do hereby certify that under requirements of P.A. 74, Michigan P.A. of 1970, the corner points mentioned in lines 1 and 2 above were in conformance with regulations and rules therefore as required in the current manual of survey instructions of the United States Department of the Interior, Bureau of Land Management or by a decree of a Court of Law and/or that the corner points mentioned in lines 3, 4 and 5 above were in conformance with the rules of the Michigan Board of Land Surveyors or by a Decree of a Court of Law; established, re-established, monumented, re-monumented, recovered, found as expressed below:

NOTE: Not more than 4 corners, all in the same town and range, may be recorded on this certificate.

	A	B	C	D	E	F	G	H	I	J	K	L
2	6	5	4	3	2	1						
3												
4	7	8	9	10	11	12						
5												
6	18	17	16	15	14	13						
7												
8	19	20	21	22	23	24						
9												
10	30	29	28	27	26	25						
11												
12	31	32	33	34	35	36						
13												

A. Description of original monument and accessories and/or subsequent restoration:

(L-13) S. $\frac{1}{4}$ Cor. Sec. 36, T 30 N, R 2 E
Post set by Lewis Clawson 1-10-1840.
24" J. Pine N 47° E 50 links
10" W. Pine N 37° W 47 links
DNR Survey

Montmorency County Road Commission Notes:
1" pipe & cap
10" Oak N 28° E 37 links (24.42')
5" Oak N 45° W 51.5 links (33.99')

B. Description of corner evidence found and/or method applied in restoring or reestablishing corner:


(L-13) S. $\frac{1}{4}$ Cor. Sec. 36, T 30 N, R 2 E
Found DNR Monument.
12" Oak S 85° W 14.15' -- Tag #26466, James Schwandt
12" Oak S 25° W 19.94' -- Tag #26466, James Schwandt
8" Maple N 5° E 15.35' -- Tag #26466, James Schwandt
8" Oak N 38° W 33.95' -- (DNR Land Corner 1960) (Road Commission Notes).
N. $\frac{1}{4}$ Cor. Sec. 1, 29/2, 7.2' East (DNR Monument).
No evidence of original corner.

Accepted as the best available evidence of the reestablishment of the original corner.

C. Description of monument for corner and accessories established to perpetuate locating the position of the corner:

(L-13) S. $\frac{1}{4}$ Cor. Sec. 36, T 30 N, R 2 E
DNR Monument.
12" Oak S 85° W 14.15'
12" Oak S 25° W 19.94'
8" Maple N 5° E 15.35'
13" Oak S 70° E 26.12'
8" Oak S 38° W 33.95'
N. $\frac{1}{4}$ Cor. Sec. 1, 29/2, 7.2' East.

Witnesses marked with a 30 penny spike & I.D. tag #18660.

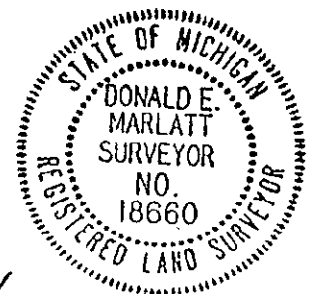

Signed by Donald E. Marlatt

Date 11-9-1994

Surveyor's Michigan License No. 18660