

# LAND CORNER RECORDATION CERTIFICATE

Filing Requirement of Act 74, Mich. PA 1970

For Corners In: Montmorency (County)	Located In	Corner Code #	
1. Public Land Survey	T _____ R _____	_____	_____
	T _____ R _____	_____	_____
2. Property Controlling in Section	S <u>20</u> T <u>30N</u> R <u>2E</u>	<u>11</u>	_____
	S _____ T _____ R _____	_____	_____
3. Miscellaneous Property in Section	S _____ T _____ R _____	_____	_____
	S _____ T _____ R _____	_____	_____
4. Lot No: _____	Recorded Plat: _____		
5. Private Claims: _____			

Register of Deeds Stamp & File Number

	A	B	C	D	E	F	G	H	I	J	K	L	M
1													
2	6	5	4	3	2	1							
3													
4	7	8	9	10	11	12							
5													
6	18	17	16	15	14	13							
7													
8	19	20	21	22	23	24							
9		●											
10	30	29	28	27	26	25							
11													
12	31	32	33	34	35	36							
13													

I, Carl T. Kiiskila, in a field survey on August 11, 2001 do hereby state that under requirements of PA 74, Michigan PA of 1970, the corner points mentioned in lines 1 and 2 above were in conformance with regulations and rules therefore as required in the current manual of survey instructions of the United States Department of the Interior, Bureau of Land Management or by a decree of a Court of Law and/or that the corner points mentioned in lines 3, 4 and 5 above were in conformance with the rules of the Michigan Board of Land Surveyors or by a Decree of a Court of Law; established, re-established, monumented, recovered, found as expressed below:

**NOTE: Not more than 2 corners, all in the same town and range, may be recorded on this certificate.**

**A. Description of original monument and accessories and/or subsequent restoration:**


11- This corner position was not established during the original government survey.

**B. Description of corner evidence found and/or method applies in restoring or re-establishing corner:**

11- Established the Northeast corner of the Southwest quarter of the Southwest quarter of section 20 as per B.L.M. instructions for the subdivision of a section.

**C. Description of monument for corner and accessories established to perpetuate locating the position of the corner:**

11- Set 1" X 32" iron pipe with P.S. cap #33981  
 Wit: 14" Cedar S46°W 84.21'  
 16" Red Pine N12°W 19.35'  
 Carsonite Post West 70'  
 PK Nail foot Bridge SW 20.0'  
 Corner falls in Thunder Bay River

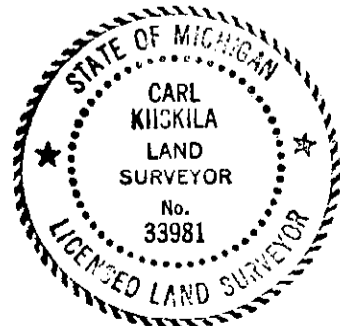

Signed by: Carl T. Kiiskila  
 Surveyor's Michigan License No.: 33981

Date: 3-11-02