

LAND CORNER RECORDATION CERTIFICATE
Filing Requirement of Act 74, Mich. PA 1970

For Corners In: _____
Montmorency _____
(County)

	Located In	Corner Code #
1. Public Land Survey	T <u>30N</u> R <u>2E</u>	<u>F-12</u>
	T <u>30N</u> R <u>2E</u>	<u>F-13</u>
2. Property Controlling in Section	S _____ T _____ R _____	_____
	S _____ T _____ R _____	_____
3. Miscellaneous Property in Section	S _____ T _____ R _____	_____
	S _____ T _____ R _____	_____


4. Lot No: _____ Recorded Plat: _____

5. Private Claims: _____

I, Carl T. Kiiskila, in a field survey on May 8, 2001 do hereby state that under requirements of PA 74, Michigan PA of 1970, the corner points mentioned in lines 1 and 2 above were in conformance with regulations and rules therefore as required in the current manual of survey instructions of the United States Department of the Interior, Bureau of Land Management or by a decree of a Court of Law and/or that the corner points mentioned in lines 3, 4 and 5 above were in conformance with the rules of the Michigan Board of Land Surveyors or by a Decree of a Court of Law; established, re-established, monumented, recovered, found as expressed below:

NOTE: Not more than 2 corners, all in the same town and range, may be recorded on this certificate.

Register of Deeds Stamp & File Number

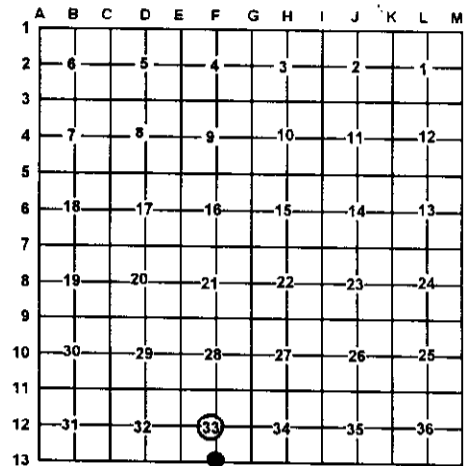

A. Description of original monument and accessories and/or subsequent restoration:

F-12 Donald E. Marlatt R.L.S. #18660 June 1983 Cert. of Survey L.3 P.206 set 1/2" rod and cap. Wit: N26°W 20" Oak 34.45', S54°W 6" Jack pine 30.6', N85°E 7" Oak 47.72'.

Donald E. Marlatt R.L.S. #18660 Aug. 1987 Cert. of survey. Found 1/2" rod and cap wit: N26°W 21" Oak 34.7', S54°W 8" Jack Pine 30.38', N75°W 15" Jack Pine 20.83', N50°E 12" Jack Pine 36.2'

F-13 G.L.O. Lewis Clason D.S. 1840
Set quarter section post
Wit: Yellow Pine 24 N44°E 25 links
Yellow Pine 24 N69°W 77 links

Kenneth J. Ostling R.L.S. #10068 1977
Set D.N.R. monument and cedar post by proportionate measurement
Wit: 2" Spruce N35°W 35.0
12" Oak N37°E 15.6

B. Description of corner evidence found and/or method applies in restoring or re-establishing corner:

F-12 Found 1/2" capped iron Marlatt L.S. #18660

F-13 Found state of Michigan D.N.R. monument

C. Description of monument for corner and accessories established to perpetuate locating the position of the corner:

F-12 Found 1/2" capped iron Marlatt L.S. #18660
Wit: 8" Jack Pine N51°E 36.24'
5" Jack Pine S11°E 22.66'
7" Jack Pine S57°W 30.84'
16" Jack Pine N65°W 20.73'
18" Oak N25°W 34.74'
Carsonite Post North 1'±

F-13 Found State of Michigan D.N.R. monument
Wit: *6" Oak N44°W 11.39'
*12" Oak N05°E 28.49'
*5" Oak N73°E 15.51'
4" Oak S20°E 29.32'
Carsonite Post North 1'±

*Old witnesses by others

Signed by: Carl T Kiiskila
Surveyor's Michigan License No.: 33981

Date: 3-7-02

