

LAND CORNER RECORDATION CERTIFICATE

Filing Requirement of Act 74, Mich. PA 1970

For Corners In: Montmorency (County)	Located In	Corner Code #	
1. Public Land Survey	T _____ R _____		
	T _____ R _____		
2. Property Controlling in Section	S 29 T 30N R 2E	6	
	S 29 T 30N R 2E	9	
3. Miscellaneous Property in Section	S _____ T _____ R _____		
	S _____ T _____ R _____		


Register of Deeds Stamp & File Number

4. Lot No: _____ Recorded Plat: _____

5. Private Claims: _____

I, Carl T. Kiiskila, in a field survey on April 18, 2001 do hereby state that under requirements of PA 74, Michigan PA of 1970, the corner points mentioned in lines 1 and 2 above were in conformance with regulations and rules therefore as required in the current manual of survey instructions of the United States Department of the Interior, Bureau of Land Management or by a decree of a Court of Law and/or that the corner points mentioned in lines 3, 4 and 5 above were in conformance with the rules of the Michigan Board of Land Surveyors or by a Decree of a Court of Law; established, re-established, monumented, recovered, found as expressed below:

NOTE: Not more than 2 corners, all in the same town and range, may be recorded on this certificate.

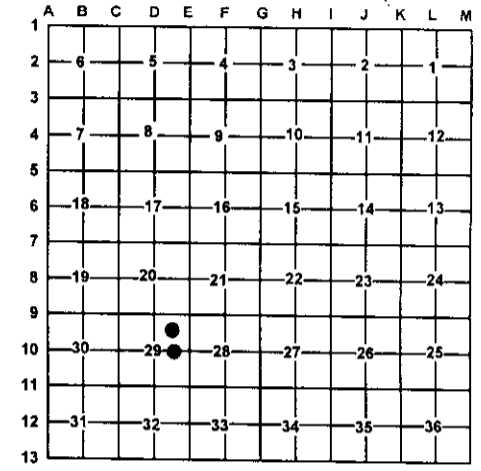

A. Description of original monument and accessories and/or subsequent restoration:

6- This corner position was not established during the original government survey. 9- This corner position was not established during the original government survey.

B. Description of corner evidence found and/or method applies in restoring or re-establishing corner:

6- Established the Northwest corner of the Southeast quarter of the Northeast quarter of section 29 as per B.L.M. instructions for the subdivision of a section. 9- Established the Southwest corner of the Southeast quarter of the Northeast quarter for section 29 as per B.L.M. instructions for the subdivision of a section.

C. Description of monument for corner and accessories established to perpetuate locating the position of the corner:

- | | |
|---|---|
| <p>6- Set 5/8" X 32" rered with P.S. cap #33981</p> <p>Wit: 6"-8" Twin Maple S22°W 28.46'</p> <p> 9" White Birch N52°W 31.71'</p> <p> Power Pole N58°E 29.22'</p> <p> 6" Twin Maple S67°E 26.14'</p> | <p>9- Set 5/8" X 32" rered with P.S. cap #33981</p> <p>Wit: 4" Maple N17°w 16.73'</p> <p> 4" Balsam S75°W 10.44'</p> <p> 3" Balsam South 13.41'</p> <p> 5" Twin Maple S74°E 32.11'</p> |
|---|---|

Signed by: Carl T. Kiiskila

Surveyor's Michigan License No.: 33981

Date: 3-7-02

