

LAND CORNER RECORDATION CERTIFICATE

Filing Requirement of Act 74, Mich. PA 1970


For Corners In:
Montmorency
 (County)

		Located In		Corner Code #	
1. Public Land Survey	T	_____	R	_____	
	T	_____	R	_____	
2. Property Controlling in Section	S	31	T	30N R 2E	5
	S	31	T	30N R 2E	9
3. Miscellaneous Property in Section	S	_____	T	_____ R	_____
	S	_____	T	_____ R	_____
4. Lot No: _____	Recorded Plat: _____				
5. Private Claims: _____					

Register of Deeds Stamp & File Number

I, Carl T. Kiiskila, in a field survey on May 3, 2001 do hereby state that under requirements of PA 74, Michigan PA of 1970, the corner points mentioned in lines 1 and 2 above were in conformance with regulations and rules therefore as required in the current manual of survey instructions of the United States Department of the Interior, Bureau of Land Management or by a decree of a Court of Law and/or that the corner points mentioned in lines 3, 4 and 5 above were in conformance with the rules of the Michigan Board of Land Surveyors or by a Decree of a Court of Law; established, re-established, monumented, recovered, found as expressed below:

NOTE: Not more than 2 corners, all in the same town and range, may be recorded on this certificate.

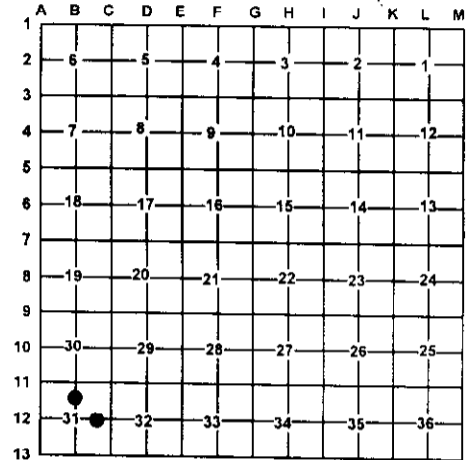

A. Description of original monument and accessories and/or subsequent restoration:

5-This corner position was not established during the original government survey.

9-This corner position was not established during the original government survey.

Donald E. Marlatt R.L.S. #18660 L.2 P.404 Cert. of survey
 March 1978 set 1/2" rod and cap no witnesses given

B. Description of corner evidence found and/or method applies in restoring or re-establishing corner:

5- Found 1/2" capped iron rod "Marlatt" #18660

9- Established the Southwest corner of the Southeast quarter of the Northeast quarter of section 31 per B.L.M. instructions for the subdivision of a section.

C. Description of monument for corner and accessories established to perpetuate locating the position of the corner:

5 Found 1/2" capped iron

Wit: 8" Twin Oak	N60°W	20.60'
5"-7" Twin Maple	N27°W	30.49'
6" Twin maple	N57°E	16.78'
4" Maple	S28°W	13.19'
Carsonite Post	North	1'±

9- Set 5/8" X 32" rered with P.S. cap #33981

Wit: 4" Oak	N09°E	29.47'
16" Cherry	N41°W	41.12'
26" Red Pine	S16°W	84.34'
26" Oak	S47°E	88.51'
carsonite Post	North	1'±

Signed by: Carl T Kiiskila
 Surveyor's Michigan License No.: 33981

Date: 3-7-02