

Montmorency County Remonumentation

Liber 00012 Page 0181

LAND CORNER RECORDATION CERTIFICATE

Filing Requirement of Act 74, Mich. P.A. 1970

For corners in

Montmorency <small>(County)</small>	Located In:	Corner Code #
	AVERY TWP.	
1. Public Land Survey	T 30N R 3E	F-13
	T _____ R _____	_____
	T _____ R _____	_____
	T _____ R _____	_____
2. Property Controlling in Section	S _____ T _____ R _____	_____
	S _____ T _____ R _____	_____
3. Miscellaneous Property in Sec.	S _____ T _____ R _____	_____
	S _____ T _____ R _____	_____

STATE OF MICHIGAN
MONTMORENCY COUNTY
Recorded & Filed

11-21-1995 13:22:40

A. PANGAN-MCELROY
REGISTER OF DEEDS

Register of Deeds Stamp & File Number

4. Lot No. _____, Recorded Plat _____
5. Private Claims _____

I, Donald E. Marlatt, in a field survey on 4-5, 19 95, do hereby certify that under requirements of P.A. 74, Michigan P.A. of 1970, the corner points mentioned in lines 1 and 2 above were in conformance with regulations and rules therefore as required in the current manual of survey instructions of the United States Department of the Interior, Bureau of Land Management or by a decree of a Court of Law and/or that the corner points mentioned in lines 3, 4 and 5 above were in conformance with the rules of the Michigan Board of Land Surveyors or by a Decree of a Court of Law; established, re-established, monumented, re-monumented, recovered, found as expressed below:

NOTE: Not more than 4 corners, all in the same town and range, may be recorded on this certificate.

A. Description of original monument and accessories and/or subsequent restoration:

(F-13) S. 1/4 corner of Section 33, T 30 N, R 3 E.
Post set by Lewis Clason in 1840.
N 20* E 16" Hemlock 7 links
N 49* W 7" Hemlock 44 links

B. Description of corner evidence found and/or method applied in restoring or reestablishing corner:

(F-13) S. 1/4 corner of Section 33, T 30 N, R 3 E.
Found no evidence of original corner.
Set concrete monument & remonumentation cap by S.P. method.

C. Description of monument for corner and accessories established to perpetuate locating the position of the corner:

(F-13) S. 1/4 corner of Section 33, T 30 N, R 3 E.
Set concrete monument & remonumentation cap. #18660
N 55* W 8" Maple 22.94'
N 26* W 8" Maple 11.04'
N 30* W 9" Maple 22.97'
N 78* E 8" W. Pine 50.52'
N 85* W 10" Maple 10.82'
Witnesses marked with a 30" penny spike & P.S. tag #18660.
Approved by the Peer Group on June 2, 1995 as a careful and faithful establishment of the position of the corner.


	A	B	C	D	E	F	G	H	I	J	K	L	M
2	6		5		4		3		2				
3													
4	7		8		9		10		11		12		
5													
6	18		17		16		15		14		13		
7													
8	19		20		21		22		23		24		
9													
10	30		29		28		27		26		25		
11													
12	31		32		33		34		35		36		
13													

SURVEY &
REMONUMENTATION
DEC 18 1995
COMMISSION

APPROVED BY
PEER GROUP

JUN 02 95

[Signature]

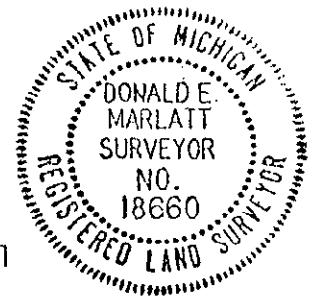

Signed by Donald E. Marlatt

Date 11-7-1995

Surveyor's Michigan License No. 18660