SURVEY & REMONUMENTATION

Montmorency County Remonumentation

Liber 00012 Page 0100

APR 2 4 1995

For corners in COMMISSION

LAND CORNER RECORDATION CERTIFICATE

Filing Requirement of Act 74, Mich. P.A. 1970

STATE OF MICHIGAN
MONTMORENCY COUNTY
Recorded & Filed

11-02-1994 15:43:16

A. PANGAN-MCELROY
REGISTER OF DEEDS

Register of Deeds Stamp & File Number

Montmorency (County)

Located In: Avery Twp. Corner Code #

1. Public Land Survey — T 30N R 3E (M-6)
   T ___ R ___
   T ___ R ___
   T ___ R ___
2. Property Controlling — S ___ T ___ R ___
   in Section — S ___ T ___ R ___
3. Miscellaneous — S ___ T ___ R ___
   Property in Sec. — S ___ T ___ R ___

APPROVED BY PEER GROUP

AUG 0 5 94

4. Lot No. _____, Recorded Plat _____
5. Private Claims _____

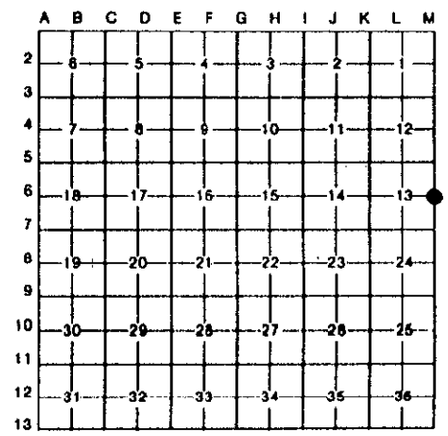

I, Larry G. Beauregard, in a field survey on May, 19 94, do hereby certify that under requirements of P.A. 74, Michigan P.A. of 1970, the corner points mentioned in lines 1 and 2 above were in conformance with regulations and rules therefore as required in the current manual of survey instructions of the United States Department of the Interior, Bureau of Land Management or by a decree of a Court of Law and/or that the corner points mentioned in lines 3, 4 and 5 above were in conformance with the rules of the Michigan Board of Land Surveyors or by a Decree of a Court of Law; established, re-established, monumented, re-monumented, recovered, found as expressed below:

NOTE: Not more than 4 corners, all in the same town and range, may be recorded on this certificate.

A. Description of original monument and accessories and/or subsequent restoration:

(M-6) GLO marked Cedar 12" ¾ post by Lewis Clason April, 1840. No other wits marked.

Frank N. Smith P.S. #754 in 1924 set square cedar and R.R. iron. In 1948 Frank found old corner he set in 1924, but had no shovel and didn't find R.R. iron. Found old Birch witness dead.

Donald E. Marlatt P.S. #18660 in 1974 found existing square cedar and R.R. iron set by Frank N. Smith. Wits: (5" Ash S 50° E 49.3') (6" Cherry S 30° E 49.5') (10" Poplar South 28.3'). Filed LCRC, L. 1, P. 105 and Certificate of Survey, L. 1, P. 571. Don also set new square cedar, corner is in edge of stream.

B. Description of corner evidence found and/or method applied in restoring or reestablishing corner:

(M-6) Found ½" bar alongside square 4" cedar post & 12" long R.R. iron for corner by Frank Smith. Replaced with 4" diam., x 36" concrete monument and 3" Aluminum cap #18654, marked Montmorency County Remonumentation corner.

STATE OF MICHIGAN
LARRY G. BEAUREGARD
SURVEYOR
NO. 18654
PROFESSIONAL SURVEYOR

C. Description of monument for corner and accessories established to perpetuate locating the position of the corner:

(M-6) ¼ corner common to Sections 13 and 18, T 30 N, R 3 E and T 30 N, R 4 E

4" x 36" Concrete monument and Re-mon. cap #18654. Accepted as a careful and faithful establishment of the position of the corner. Approved by the Peer Group on August 5, 1994.

6" Spruce N 40° W 40.9'
9" Balsam S 50° W 42.63'
C/L of old R/R grade South 30.5'±

8" Spruce S 70° W 58.65'
Tw. 6" Balsam S 12° E 37.18'

Placed blaze, 20 penny spike & P.S. tag #18654 (typ)

Signed by Larry G. Beauregard Date 11/2/94

Surveyor's Michigan License No. 18654

FORM APPROVED BY MICHIGAN STATE BOARD OF LAND SURVEYORS, JAN. 28, 1971
REVISED MAY 14, 1975
REVISED JAN., 1983