

**Montmorency County Remonumentation**

**LAND CORNER RECORDATION CERTIFICATE**  
**Filing Requirement of Act 74, Mich. P.A. 1970**

STATE OF MICHIGAN  
 MONTMORENCY COUNTY  
 Recorded & Filed

09-27-1996 13:26:58

A. PANGAN-MCELROY  
 REGISTER OF DEEDS

Liber **00012** Page **0200**

**Register of Deeds Stamp & File Number**

For corners in

<u>Montmorency</u> (County)	Located In: Rust Township	Corner Code # D-1
1. Public Land Survey	T <u>30N</u> R <u>4E</u>	<u>D-1</u>
	T _____ R _____	_____
	T _____ R _____	_____
	T _____ R _____	_____
2. Property Controlling in Section	S _____ T _____ R _____	_____
	S _____ T _____ R _____	_____
3. Miscellaneous Property in Sec.	S _____ T _____ R _____	_____
	S _____ T _____ R _____	_____

4. Lot No. \_\_\_\_\_, Recorded Plat \_\_\_\_\_  
 5. Private Claims \_\_\_\_\_

I, Larry G. Beauregard, in a field survey on April, 1996, do hereby certify that under requirements of P.A. 74, Michigan P.A. of 1970, the corner points mentioned in lines 1 and 2 above were in conformance with regulations and rules therefore as required in the current manual of survey instructions of the United States Department of the Interior, Bureau of Land Management or by a decree of a Court of Law and/or that the corner points mentioned in lines 3, 4 and 5 above were in conformance with the rules of the Michigan Board of Land Surveyors or by a Decree of a Court of Law; established, re-established, monumented, re-monumented, recovered, found as expressed below:

**NOTE: Not more than 4 corners, all in the same town and range, may be recorded on this certificate.**

A	B	C	D	E	F	G	H	I	J	K	L	M
2	6		5		4		3		2		1	
3												
4	7		8		9		10		11		12	
5												
6	18		17		16		15		14		13	
7												
8	19		20		21		22		23		24	
9												
10	30		29		28		27		26		25	
11												
12	31		32		33		34		35		36	
13												

**A. Description of original monument and accessories and/or subsequent restoration:**

D-1 North 1/4 Corner Section 5,  
 No corner set on original survey.  
 1982 - Kenneth J. Ostling RLS # 140068 DNR surveyor set DNR std. corner by proportionate measurement, midpoint on line between section corners. No U.S. evidence. Then filed LCRC Rec. L. 1, P. 331. Wit's marked:  
 (N 42° E 12.8' 12" Cedar) (S 89° W 40.1' 18" Cedar).  
 1995 - Fred J. King RLS # 25852 found and accepted DNR std. corner. No wit's marked. Survey recorded L. 10004, P. 0247 Montmorency County Records.

**B. Description of corner evidence found and/or method applied in restoring or reestablishing corner:**

Found recorded wit's & DNR std. corner in good condition. 4" aluminum cap on 1" x 3' pipe with DNR post along side.

**SURVEY &  
 REMONUMENTATION**

MAY 22 1997

COMMISSION

**APPROVED BY  
 PEER GROUP**

JUN 07 96


*L.G.B.*

**C. Description of monument for corner and accessories established to perpetuate locating the position of the corner:**

D-1 North 1/4 Corner Section 5  
 4" Aluminum cap on 1" x 3' pipe. Accepted as a careful and faithful establishment of the position of the corner. Approved by the Peer Group on June 7, 1996.

N 42° E 12.8' 15" Cedar R & M  
 S 89° W 40.1' 18" Cedar (R) 40.8' (M)  
 S 50° E 33.48' 16" Cedar  
 N 15° W 28.10' 17" Cedar

Placed 60d penny spike, P.S. tag # 18654 & blaze. (typ)

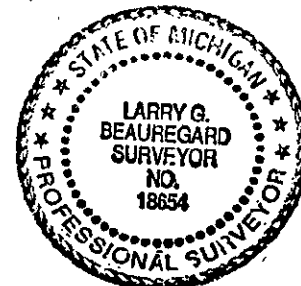

Signed by Larry G. Beauregard  
 Surveyor's Michigan License No. 18654

Date 9-24-96

*R*

*J.B.*