

Montmorency County Remonumentation
LAND CORNER RECORDATION CERTIFICATE
Filing Requirement of Act 74, Mich. P.A. 1970

STATE OF MICHIGAN
 MONTMORENCY COUNTY
 Recorded & Filed

09-27-1996 13:26:44

A. PANGAN-MCELROY
 REGISTER OF DEEDS

For corners in

<u>Montmorency</u> (County)	Located In: Rust Township	Corner Code # E-1
1. Public Land Survey	T <u>30N</u> R <u>4E</u>	<u>E-1</u>
	T _____ R _____	_____
	T _____ R _____	_____
	T _____ R _____	_____
2. Property Controlling in Section	S _____ T _____ R _____	_____
	S _____ T _____ R _____	_____
3. Miscellaneous Property in Sec.	S _____ T _____ R _____	_____
	S _____ T _____ R _____	_____

Liber **00012** Page **0199**
 Register of Deeds Stamp & File Number

4. Lot No. _____, Recorded Plat _____
 5. Private Claims _____

A	B	C	D	E	F	G	H	I	J	K	L	M
2	6	5	4	3	2	1						
3												
4	7	8	9	10	11	12						
5												
6	18	17	16	15	14	13						
7												
8	19	20	21	22	23	24						
9												
10	30	29	28	27	26	25						
11												
12	31	32	33	34	35	36						
13												

I, Larry G. Beauregard, in a field survey on April, 19 96, do hereby certify that under requirements of P.A. 74, Michigan P.A. of 1970, the corner points mentioned in lines 1 and 2 above were in conformance with regulations and rules therefore as required in the current manual of survey instructions of the United States Department of the Interior, Bureau of Land Management or by a decree of a Court of Law and/or that the corner points mentioned in lines 3, 4 and 5 above were in conformance with the rules of the Michigan Board of Land Surveyors or by a Decree of a Court of Law; established, re-established, monumented, re-monumented, recovered, found as expressed below:

NOTE: Not more than 4 corners, all in the same town and range, may be recorded on this certificate.

A. Description of original monument and accessories and/or subsequent restoration:
 E-1 Section corner common to Sec's 4 & 5

1940 - Lewis Clawson D.S. intersected 3rd. correction line & marked Aspen 8" No wit's marked.

1982 - Kenneth J. Ostling RLS # 10068 DNR surveyor set std. DNR corner by single proportion measurement between N 1/4 Section 4 & restored NW corner Section 5. No evidence of previous corner. Then filed LCRC Rec. L. 1, P. 331. Wit's marked(N 62° E 26.9' 14" Tamrack) (S 51° W 29.9' 10" Tamrack).

B. Description of corner evidence found and/or method applied in restoring or reestablishing corner:

Found DNR std. corner in good condition (4" aluminum cap on 1" x 3' pipe) with DNR post along side & witnesses mentioned above.

**SURVEY &
 REMONUMENTATION**

MAY 22 1997

COMMISSION

**APPROVED BY
 PEER GROUP**

JUN 07 96

R.L.B.


C. Description of monument for corner and accessories established to perpetuate locating the position of the corner:

E-1 Section corner common to Sec's 4 & 5

4" aluminum cap on 1" x 3' pipe. Accepted as the best available evidence of the position of the original corner. Approved by the Peer Group on June 7, 1996.

- S 55° W 29.9' 13" Tamrack (R)
- N 62° E 26.9' 15" Tamrack (R)
- N 15° W 24.2' 9" R. Oak
- N 37° W 48.9' 8" Balsam

Placed 60d penny spike, P.S. tag # 18654 & blaze. (typ)

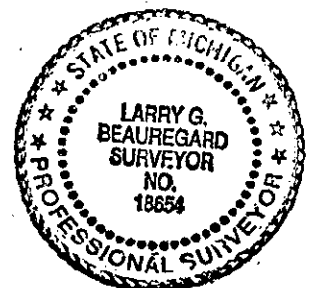

Signed by Larry G. Beauregard Date 9-24-96
 Surveyor's Michigan License No. 18654