

MAY 18 1997

LAND CORNER RECORDATION CERTIFICATE
Filing Requirement of Act 74, Mich. P.A. 1970

For corners in

MONTMORENCY (County)	Located In:	Corner Code #
RUST TWP.	T 30N R 4E	F - 1
1. Public Land Survey	T _____ R _____	_____
	T _____ R _____	_____
	T _____ R _____	_____
	T _____ R _____	_____
2. Property Controlling in Section	S _____ T _____ R _____	_____
	S _____ T _____ R _____	_____
3. Miscellaneous Property in Sec.	S _____ T _____ R _____	_____
	S _____ T _____ R _____	_____

STATE OF MICHIGAN
MONTMORENCY COUNTY
Recorded & Filed

11-01-1996 09:42:37

A. PANGAN-MCELROY
REGISTER OF DEEDS

Register of Deeds Stamp & File Number

- 4. Lot No. _____, Recorded Plat _____
- 5. Private Claims _____

	A	B	C	D	E	F	G	H	I	J	K	L	M
2	6		5		4		3		2		1		
3													
4	7		8		9		10		11		12		
5													
6	18		17		16		15		14		13		
7													
8	19		20		21		22		23		24		
9													
10	30		29		28		27		26		25		
11													
12	31		32		33		34		35		36		
13													

I, DONALD E MARLATT, in a field survey on 7-1-1996, 1996, do hereby certify that under requirements of P.A. 74, Michigan P.A. of 1970, the corner points mentioned in lines 1 and 2 above were in conformance with regulations and rules therefore as required in the current manual of survey instructions of the United States Department of the Interior, Bureau of Land Management or by a decree of a Court of Law and/or that the corner points mentioned in lines 3, 4 and 5 above were in conformance with the rules of the Michigan Board of Land Surveyors or by a Decree of a Court of Law; established, re-established, monumented, re-monumented, recovered, found as expressed below:

NOTE: Not more than 4 corners, all in the same town and range, may be recorded on this certificate.

A. Description of original monument and accessories and/or subsequent restoration:

F - 1 NORTH 1/4 CORNER OF SEC. 4
NO CORNER SET ON ORIGINAL SURVEY

B. Description of corner evidence found and/or method applied in restoring or reestablishing corner:

F - 1 NORTH 1/4 CORNER OF SEC. 4
SET CORNER ON TOWNSHIP LINE BY SINGLE PROPORTION METHOD.
FOUND STEEL POST & SQ. CEDAR 30' WEST & 46' NORTH (NOT ACCEPTED)



JUL 12 96


S.S.B.

SOUTH CORNER COMMON TO SEC'S 32 & 33, T31N, R4E IS 42.82' EAST.

NOTE: MSHD SURVEY DATED 4-5-1966 WAS NOT ACCEPTED FOR CORNER POSITION.

C. Description of monument for corner and accessories established to perpetuate locating the position of the corner:

F - 1 NORTH 1/4 CORNER OF SEC. 4, T30N, R4E.
SET CONC. MONUMENT WITH REMON. CAP.
S80°E 18" POPLAR 17.43'
S15°E 10" POPLAR 25.35'
S45°W 12" POPLAR 19.23'
N82°E 11" POPLAR 36.85'

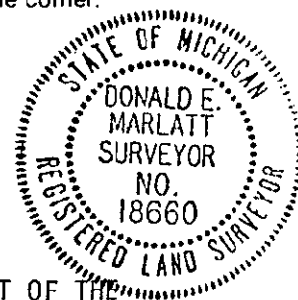

WITNESSES MARKED WITH 30 PENNY SPIKES & P.S. TAGS # 18660
APPROVED BY PEER GROUP JULY 12, 1996 AS A CAREFUL AND FAITHFUL ESTABLISHMENT OF THE POSITION OF THE CORNER.

Signed by Donald E Marlatt Date 10/28/96
Surveyor's Michigan License No. 18660