

DEC 18 1995

COMMISSION

For corners in

Montmorency (County)	Located In:	Corner Code #
	Rust Township	
1. Public Land Survey	T 30 N R 4 E	K-1
	T _____ R _____	_____
	T _____ R _____	_____
	T _____ R _____	_____
2. Property Controlling in Section	S _____ T _____ R _____	_____
	S _____ T _____ R _____	_____
3. Miscellaneous Property in Sec.	S _____ T _____ R _____	_____
	S _____ T _____ R _____	_____

STATE OF MICHIGAN
 MONTMORENCY COUNTY
 Recorded & Filed

09-22-1995 11:29:40

A. PANGAN-MCELROY
 REGISTERED DEEDS
 Registrar of Deeds Stamp & File Number

4. Lot No. _____, Recorded Plat _____
 5. Private Claims _____

	A	B	C	D	E	F	G	H	I	J	K	L	M
2	6	5	4	3	2	1							
3													
4	7	8	9	10	11	12							
5													
6	18	17	16	15	14	13							
7													
8	19	20	21	22	23	24							
9													
10	30	29	28	27	26	25							
11													
12	31	32	33	34	35	36							
13													

I, Larry G. Beauregard, in a field survey on June 5, 19 95, do hereby certify that under requirements of P.A. 74, Michigan P.A. of 1970, the corner points mentioned in lines 1 and 2 above were in conformance with regulations and rules therefore as required in the current manual of survey instructions of the United States Department of the Interior, Bureau of Land Management or by a decree of a Court of Law and/or that the corner points mentioned in lines 3, 4 and 5 above were in conformance with the rules of the Michigan Board of Land Surveyors or by a Decree of a Court of Law, established, re-established, monumented, re-monumented, recovered, found as expressed below:

NOTE: Not more than 4 corners, all in the same town and range, may be recorded on this certificate.

A. Description of original monument and accessories and/or subsequent restoration:

5-1840, Lewis Clason, Deputy Surveyor, intersected 3rd correction line. No trees convenient.

Date Unknown, Montmorency County Road Commission Notes indicate that a cedar stake and pipe is located at South edge of grade. Wits. marked: (S 6°-30' E 21.05' 10" Cedar) (S 57° W 26.50' 9" Balsam). No data available on this corner.

1-1973, Ron Bischer, P.S. #22428, Porter's Survey, Found 2" pipe 14.5' South of fence line East and West & U-Bar 46.22' East as S. 1/4 corner Section 35, T 31 N, R 4 E. 2" pipe & 4" x 4" stake. Witnesses marked: (S 35° W 27.97' 10" Cedar) (S 5° W 22.57' 7" W. Birch) (S 60° E 29.55' 12" Balsam).

2-20-1973, Delmer E. Porter, P.S. #15410, Filed LCRC, Rec. L. 1, P. 52, Montmorency Co. Records.

4-16-1973, Delmer E. Porter, P.S. #15410, Found 2" pipe & 4" x 4" stake, Certificate of Survey, Rec. L. 1, P. 304, Montmorency County Records.

2-1985, Clifford C. Lindgren, P.S. #14098, Found 2" pipe in South side of path 46.22' West of the South 1/4 corner of Sec. T 31 N, R 4 E, and witnesses mentioned above from Porter's survey. Filed LCRC, Recorded L. 1, P. 368, 6-28-1985, Montmorency County Records.

B. Description of corner evidence found and/or method applied in restoring or reestablishing corner:

Found 2" pipe and 4" x 4" stake from witnesses recorded on LCRC L. 1, P. 368.

C. Description of monument for corner and accessories established to perpetuate locating the position of the corner:


Corner common to Sections 1 and 2, T 30 N, R 4 E

Placed 4" diam., x 36" concrete monument and Montmorency County Remonumentation, Cap P.S. #18654. Accepted as the best available evidence of the position of the original corner. Approved by the Peer Group on June 2, 1995.

- S 18° W 22.53' 8" Birch (R)
- S 35° W 27.98' 12" Cedar (R)
- S 60° W 17.00' 9" Cedar (R)
- N 63° W 15.54' 5" Ash NBT

**APPROVED BY
 PEER GROUP**

JUN 02 95 *A.B.*

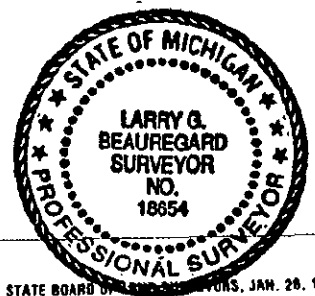

Placed blaze, 60d penny spike & P.S. tag #18654 (typ)

Signed by Larry G. Beauregard Date 9/22/95
 Surveyor's Michigan License No. 18654